


Field Notes

NW⁴SE⁴ (3)

By: Tenneson & Associates


Date: Nov 3, 1956 - Cold - Clear

Location: Curry & Phelps Addition - Block #3

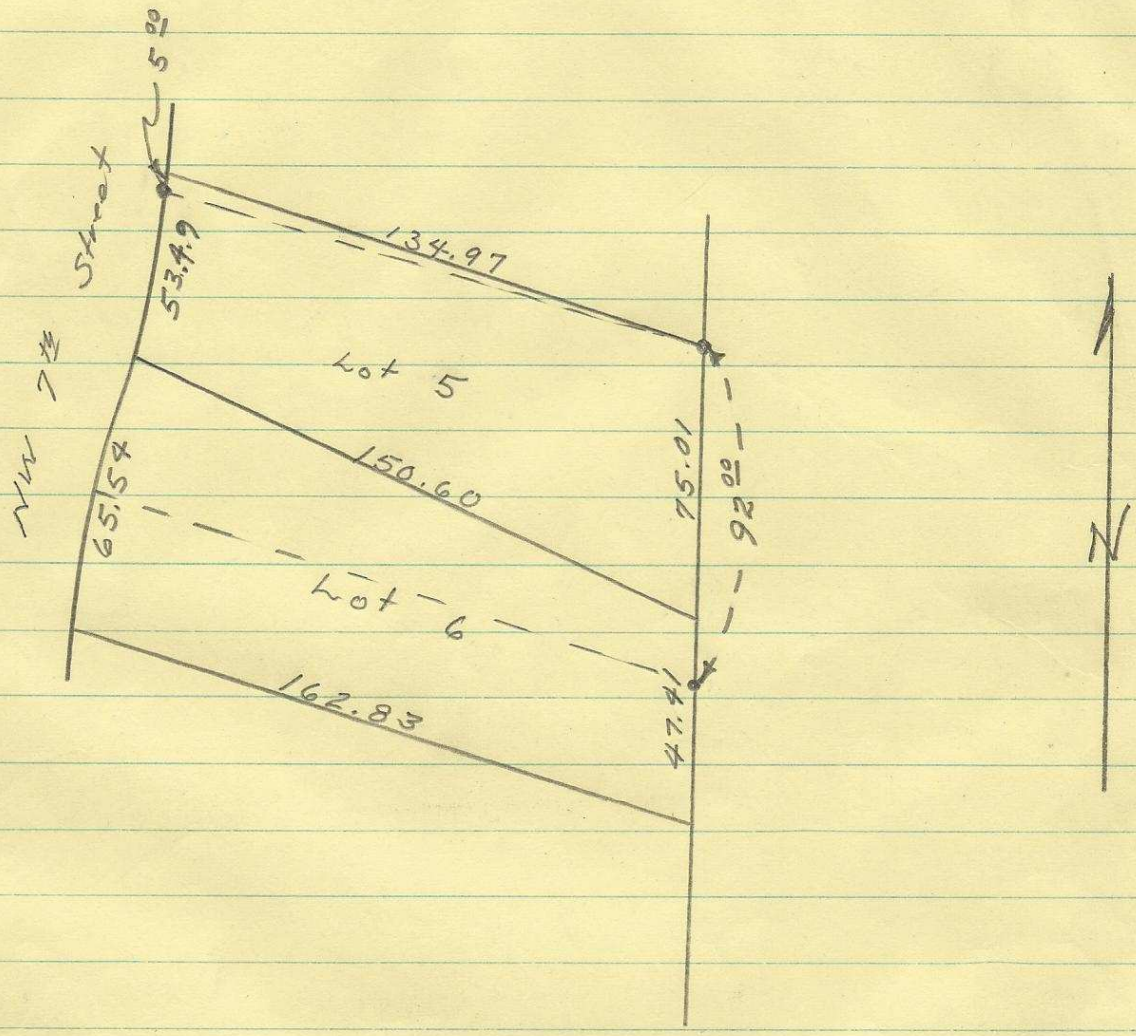

Legend

• - pins set

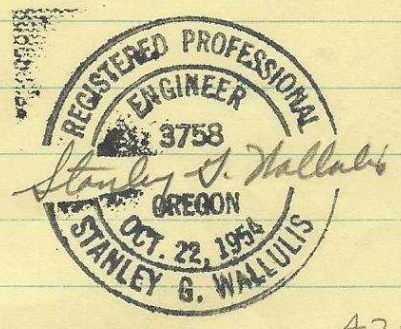

Q-1251-A1