


SE 1/4 NE 16

VERNON B TENNESON & ASSOCIATES
7-5-56

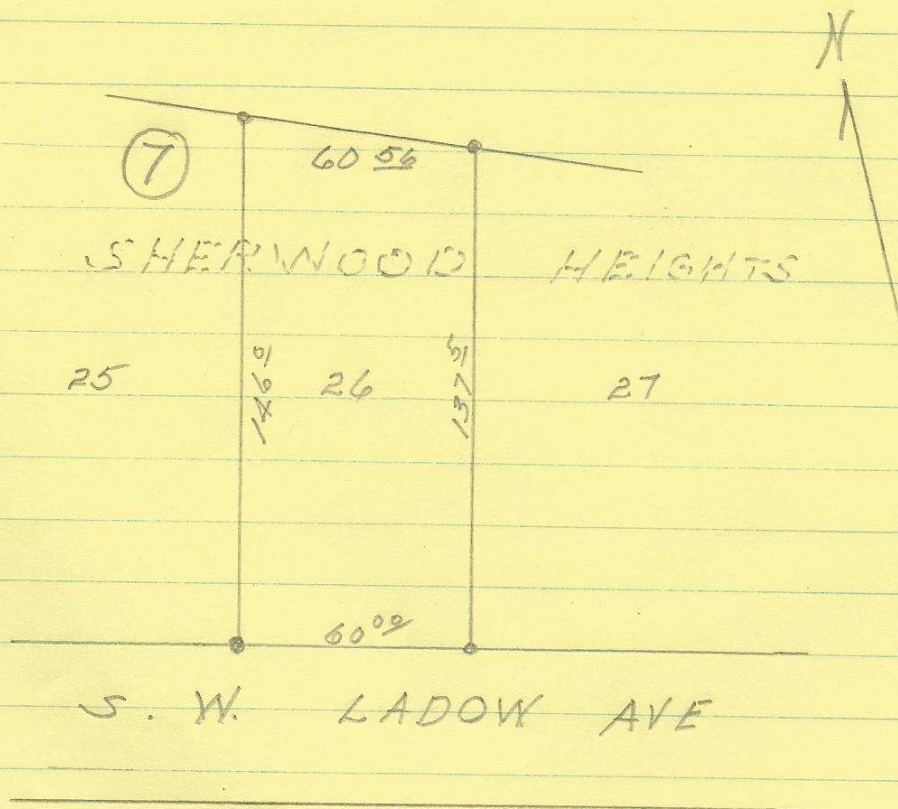

• 1/2" X 24" IRON PINS

252

8-130-2

16 AC

