


LOT 10, BLOCK 3
 CURRY'S ADDITION TO THE CITY OF PENDLETON
 UMATILLA COUNTY, OREGON

Engineer's Certificate:--

I, Stanley G. Wallulis, registered civil engineer, Certificate No. 3758 of the Oregon Board of Engineering Examiners, do hereby certify that the above plat represents the location of the existing building on the above described property, and further certify that no encroachments exist on said property.

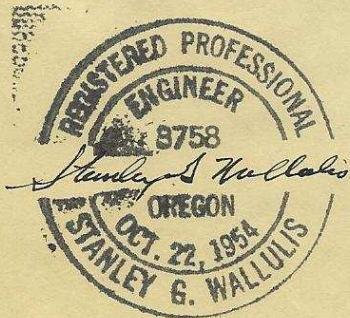

2N32 3DB

SCALE: 1" = 30'	DATE: 11-20-56
WALL AND TENNESON Engineers	
The Dalles	Oregon

Q-1435-Ax

1612-56