


S. E. Byers Ave

Plat Showing  
Blocks 141 & 142 of  
Reservation Addition to  
The City of Pendleton,  
Oregon.  
Scale: 1 inch = 100 ft.

(137)  
Surveyed and Platted  
Sept. 23-1947 -


By W. E. O. Criger -  
Ore. Reg. C. E. No 1497.

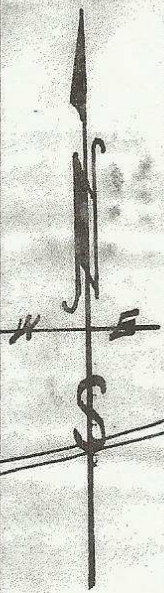

S. E. 17th St.

S. E. 16th St.

S. E. Byers Place -  
Vacated

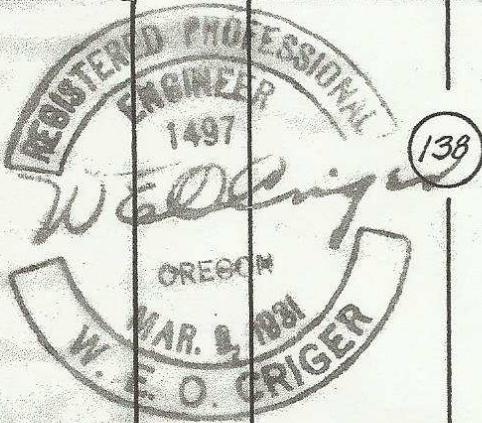

100.09

100.09

60

3983

10  
100.20

47.11

5  
100.20

57.46

60

100.30

S. E. Court Place

2N32 2DD

Monument No. 8.

Q-1482-Ax

