


Frank Walker Property
Surveyed by G. Hester White

Sec. 30

Township 4 N

Range 28 E

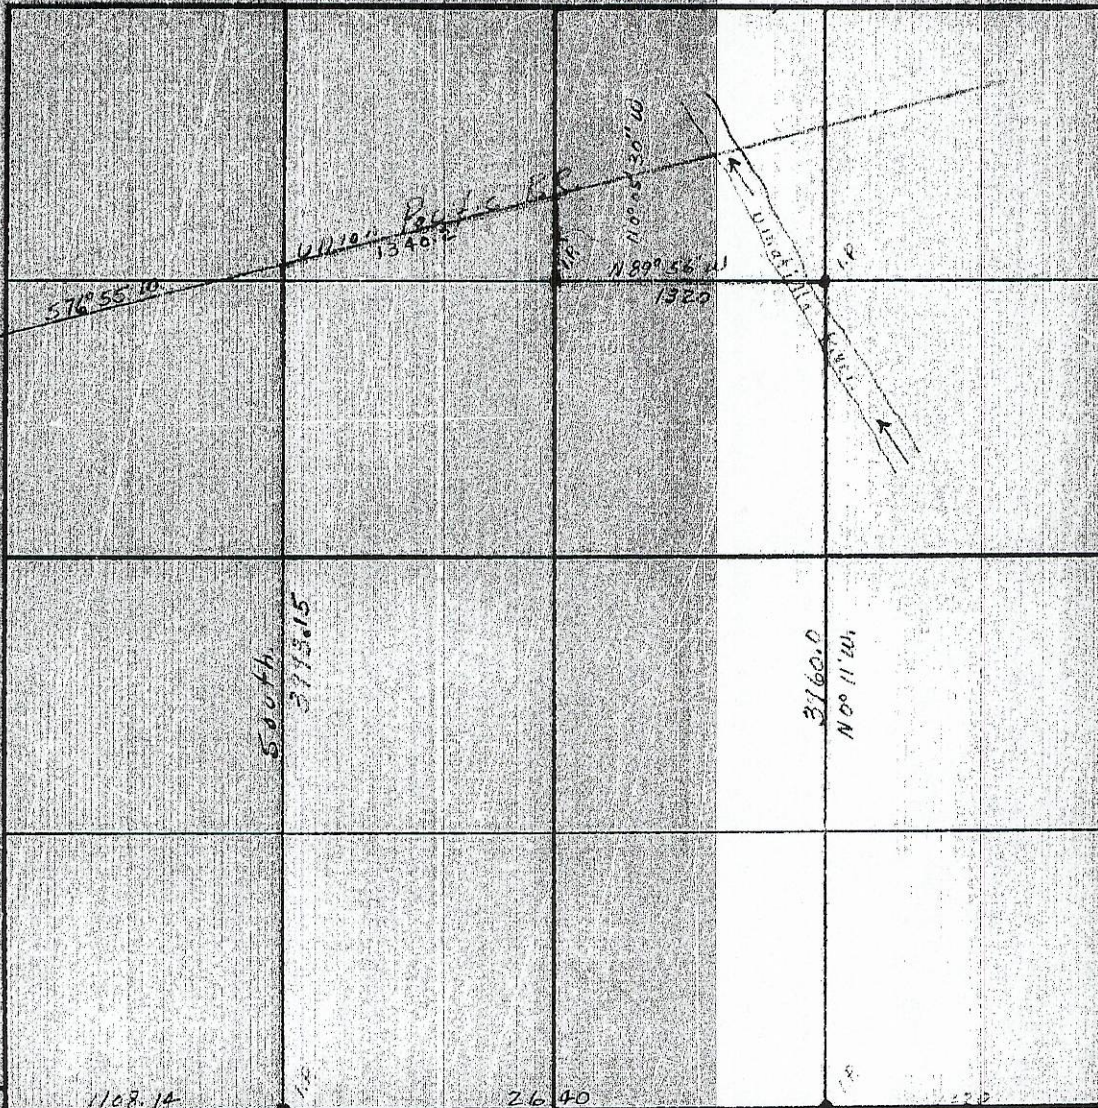

FORM 2. BOND

H. NIEDECKEN COMPANY, REG. STATIONERS, MILWAUKEE

U.S. Survey 30
S 76° 18' 30\"/>

722