


R-180-Ax

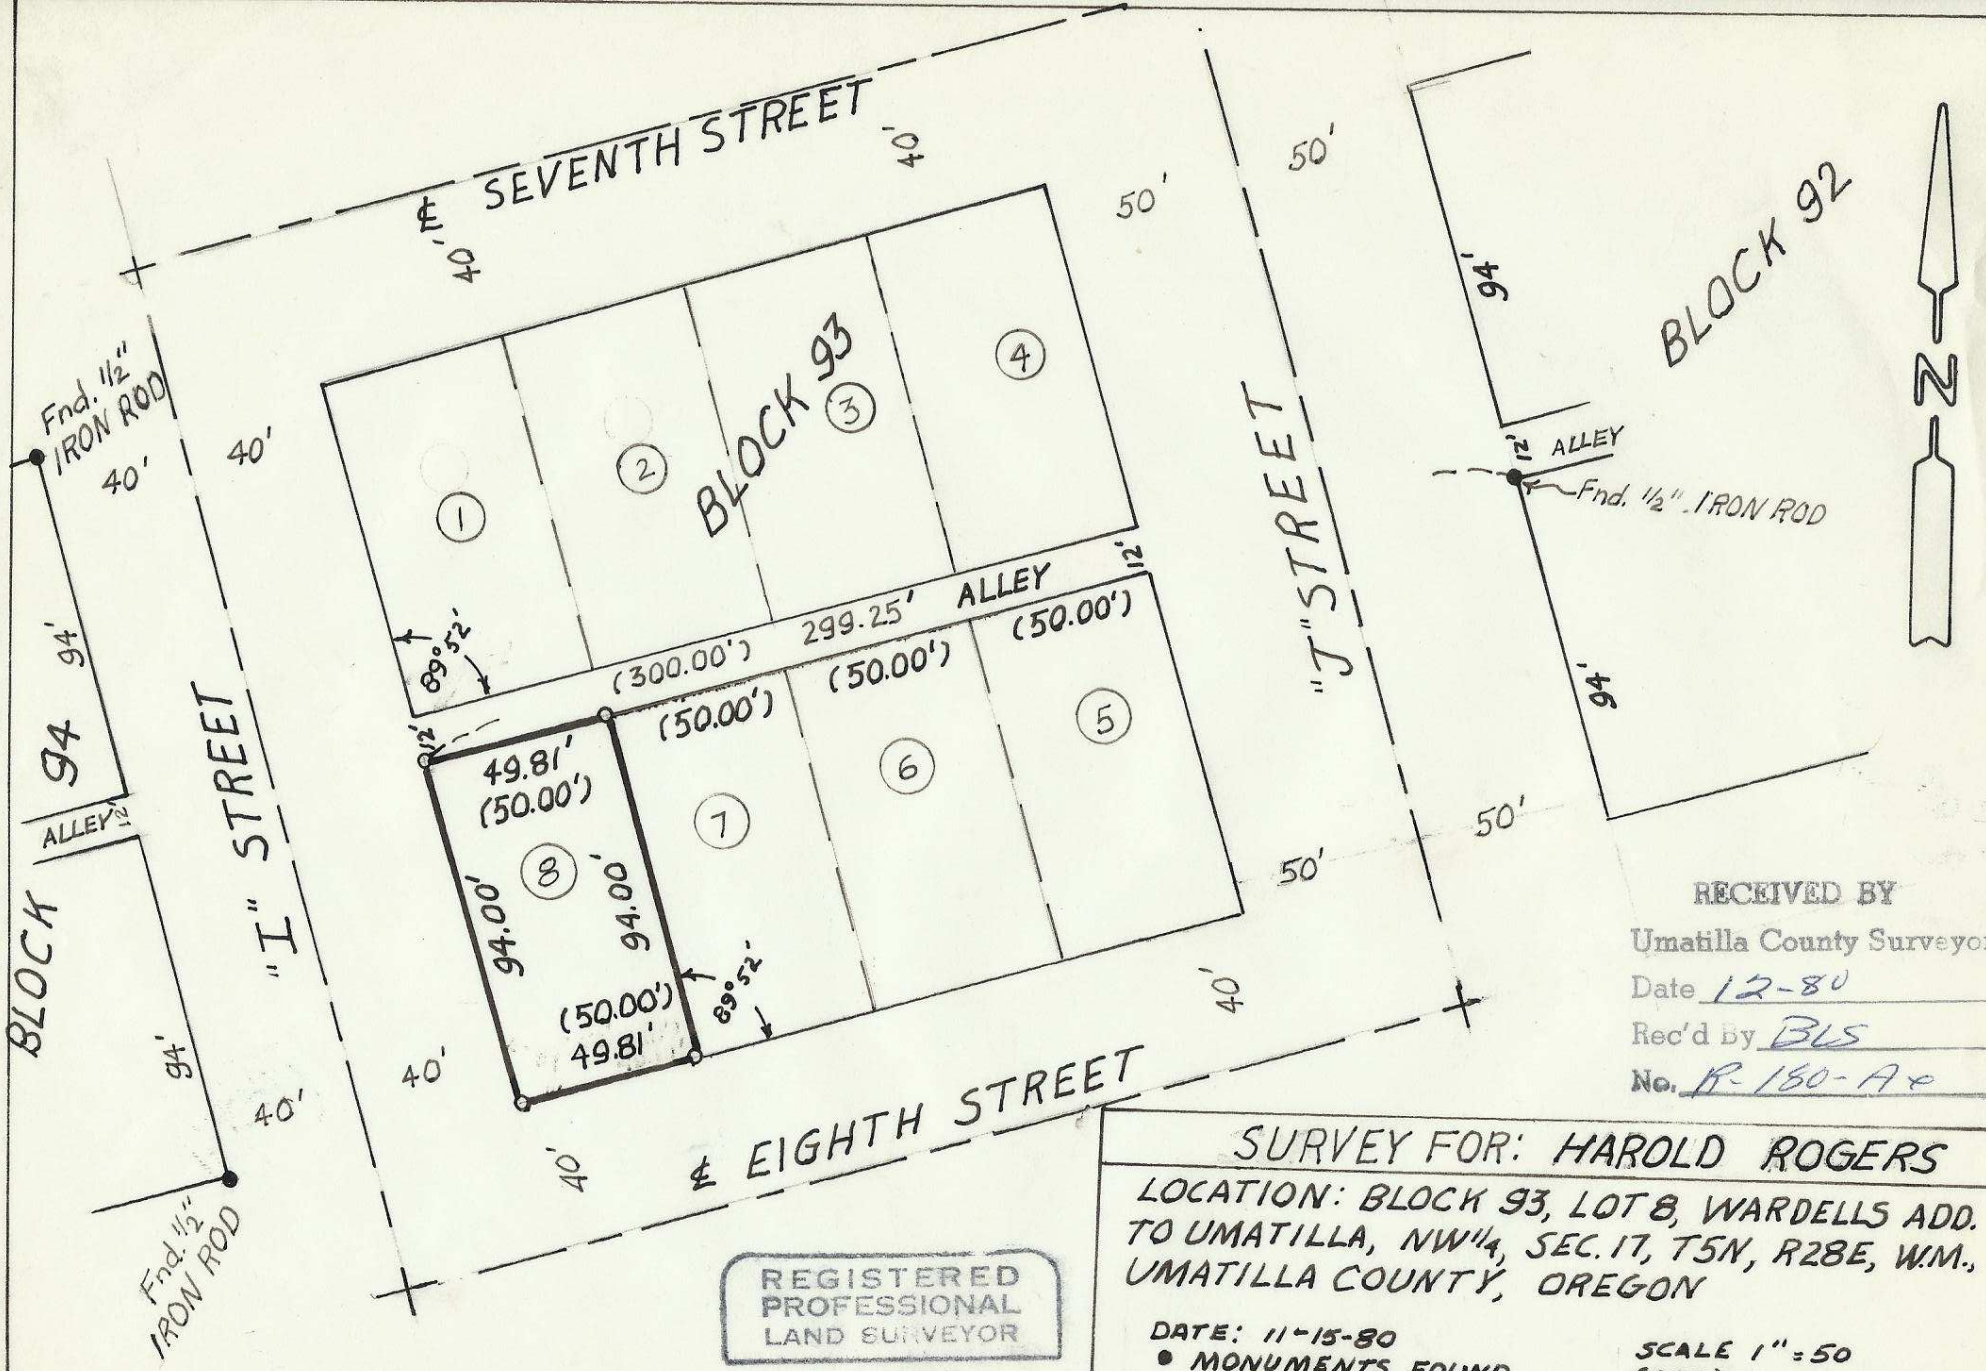

RECEIVED BY
 Umatilla County Surveyor
 Date 12-80
 Rec'd By BLS
 No. R-180-Ax

SURVEY FOR: HAROLD ROGERS
 LOCATION: BLOCK 93, LOT 8, WARDELLS ADD.
 TO UMATILLA, NW 1/4, SEC. 17, T5N, R28E, W.M.,
 UMATILLA COUNTY, OREGON

DATE: 11-15-80
 ● MONUMENTS FOUND
 ○ 1/2" IRON RODS SET

SCALE 1" = 50'
 (000) OF RECORD
 JOB # 8011290

EDWARDS SURVEYING P.O. BOX 763
 567-3336 HERMISTON, ORE.

REGISTERED
 PROFESSIONAL
 LAND SURVEYOR

G. Dennis Edwards

OREGON
 JULY 16, 1971
 G. DENNIS EDWARDS
 951