


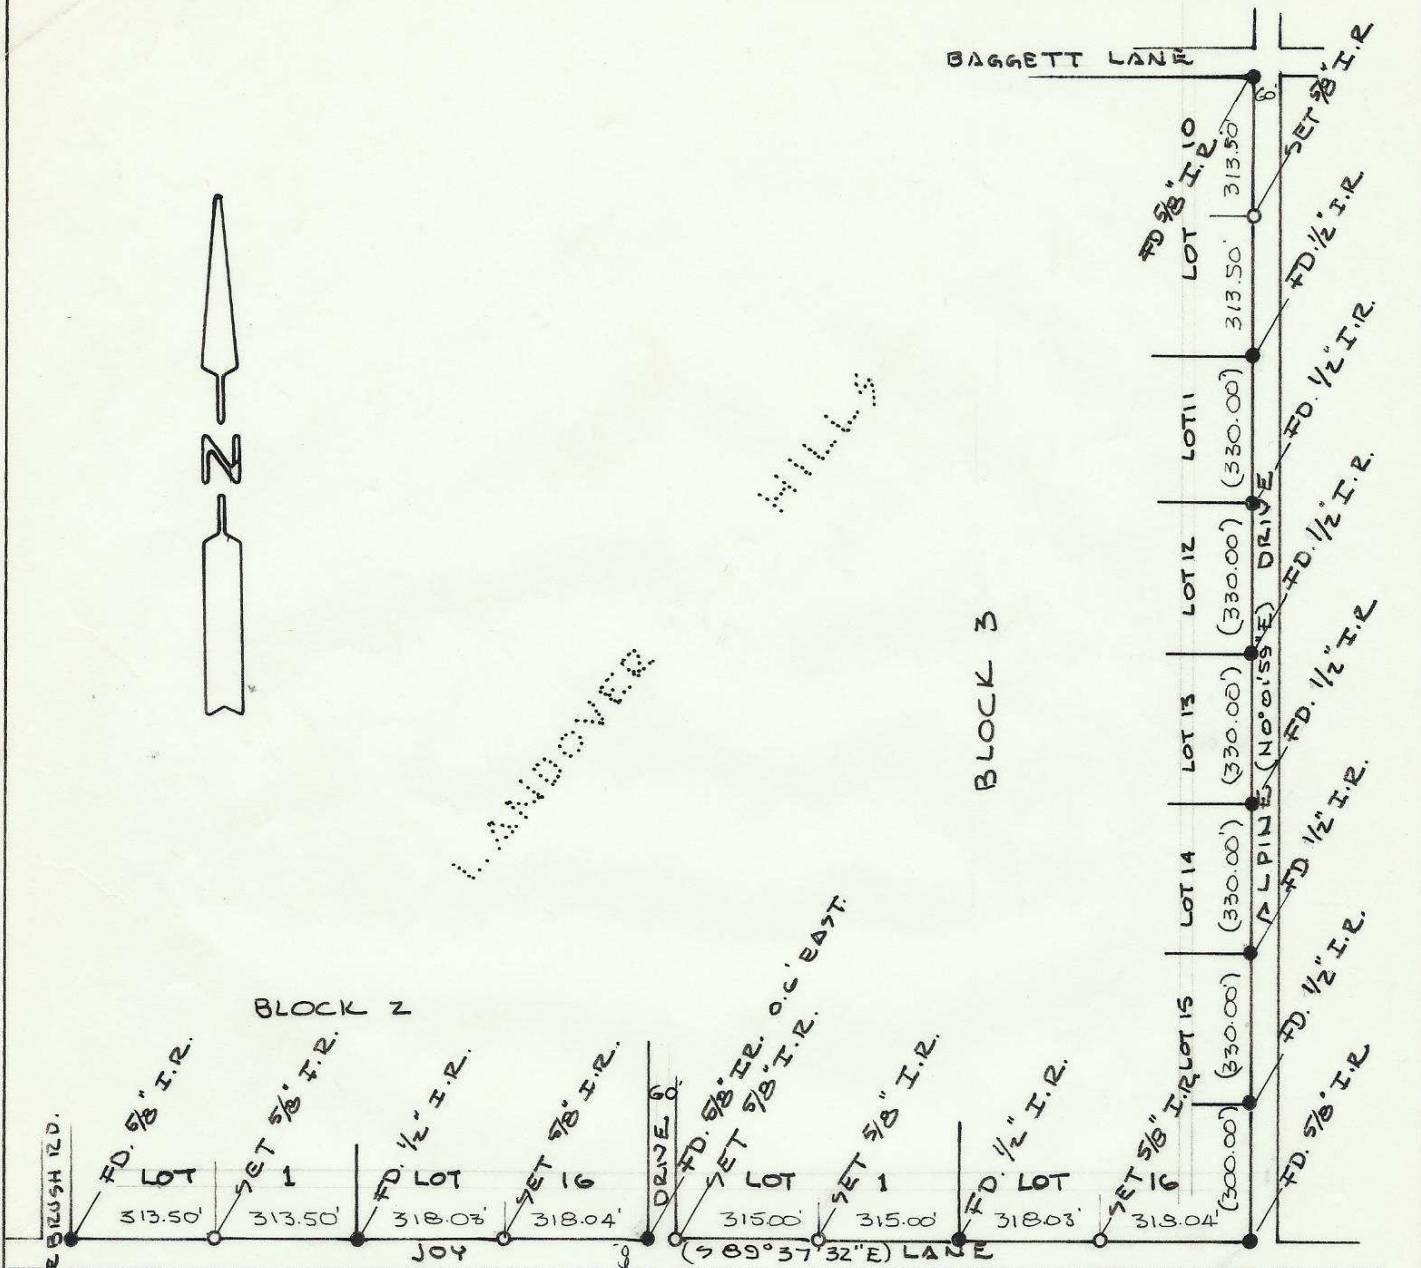

LANDOVER HILLS

BAGGETT LANE



REGISTERED PROFESSIONAL LAND SURVEYOR

G. Dennis Edwards

OREGON JULY 16, 1971 G. DENNIS EDWARDS 951

(N 0° 01' 54 1/2" W)

CACTUS

300.00'

FD 1/2" I.R.

LOT 4 BL. 4

RECEIVED BY Umatilla County Surveyor Date 4-81 Rec'd By BLS No. S-31-Ax

SURVEY FOR: LEROY HAGGEN LOCATION: LANDOVER HILLS SEC. 35 T5N R22E, W7M. UMATILLA CO., OREGON MONUMENTS FOUND DATE: 4-2-81 MONUMENTS SET SCALE: 1" = 400' JOB NO. S 8103051 (000) RECORD EDWARDS SURVEYING P.O. BOX 763 HERMISTON, ORE 97101 567-3336

S-31-Ax