

RECEIVED BY  
Umatilla County Surveyor  
Date 12-81  
Rec'd by BLS.  
No. S-138 w/notes

BRUNING 40-22 33381

PROJ. Public Sewer Easement	WALLULIS & ASSOCIATES, INC. ENGINEERING & PLANNING	SCALE 1" = 50'	NO. 7-A
TITLE Indian Allotment U-135	PENDLETON 276-1598 OREGON	DATE Oct. 16, 1981	

S-138-Ax

Field notes for traverse route of Governmental boundary lines and easement survey


Commencing at the brass cap monumenting the center of section quarter-corner of Section 7, Township 2 North, Range 33 East, W.M.; thence North 0° 16' 15" West along the North-South centerline of Section 7, a distance of 1344.50 feet to the brass cap monumenting the Northeast corner of the Southeast quarter of the Northwest quarter of Section 7, Township 2 North, Range 33 East, W.M.; thence North 89° 57' 40" East along the South line of the Northwest quarter of the Northeast quarter of said Section 7 a distance of 29.34 feet to the point of beginning of the easement survey; thence North 30° 29' 03" East a distance of 197.90 feet to an existing sanitary sewer manhole and terminus point of this traverse.

Date: Oct. 16, 1981

By: Stanley G. Wallulis  
Stanley G. Wallulis, P.E.  
President, Wallulis and Assoc., Inc.

Notation


Above field notes were prepared to accompany a survey map for Indian Allotment U-135 dated Oct. 16, 1981.

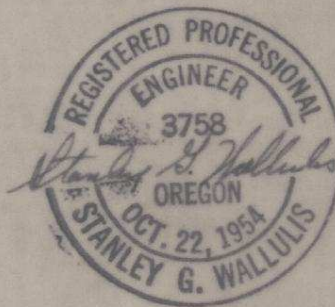

RECEIVED BY  
Umatilla County Surveyor  
Date 12-81  
Rec'd by BCS  
No. S-138 w/notes

BRUNING 40-22 33381

PROJ. Public Sewer Easement	WALLULIS & ASSOCIATES, INC. ENGINEERING & PLANNING	SCALE N.A.	NO.
TITLE Indian Allotment U-135	PENDLETON 276-1598 OREGON	DATE Oct 16, 1981	7-B

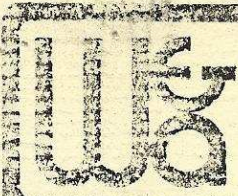

# WALLULIS & ASSOCIATES, INC.

Engineering — Planning — Surveying

XXXXXXXXX (BOX 398) PENDLETON, OR 97801 — (503) 276-1598  
XX

(\* Address replies to this office

November 11, 1981.

Mr. William D. Sandoval, Superintendent,  
Umatilla Agency, B I A,  
P. O. Box 520,  
Pendleton, Oregon 97801.

Re: Survey for easement for sewerline across Allotment U - 135 and your letter of October 19,  
1981 to City of Pendleton.

Dear Mr. Sandoval:

Submitted with this letter are the following:

1. Survey of captioned easement on reproducible mylar.
2. Field notes of above survey on reproducible mylar.
3. Two reproductions of 1 & 2 above.

The appraisal report has been completed and will be submitted by Harold Delamarter shortly.

Very truly yours,

*Stanley G. Wallulis*  
Stanley G. Wallulis, P.E.  
President

sgw;jal

Enclosures

c.c: Harold Delamarter  
City of Pendleton with enclosures  
County Surveyor

RECEIVED BY  
 Umatilla County Surveyor  
 Date 12-81  
 Rec'd by B.S.  
 No. S-138 w/notes