


SURVEY IN BLOCK 41,  
 ORIGINAL TOWN OF FREEWATER  
 SURVEYED FOR EARL KARR BY VICTOR M. McLIND  
 Nov. 1981

SCALE: 1" = 50'

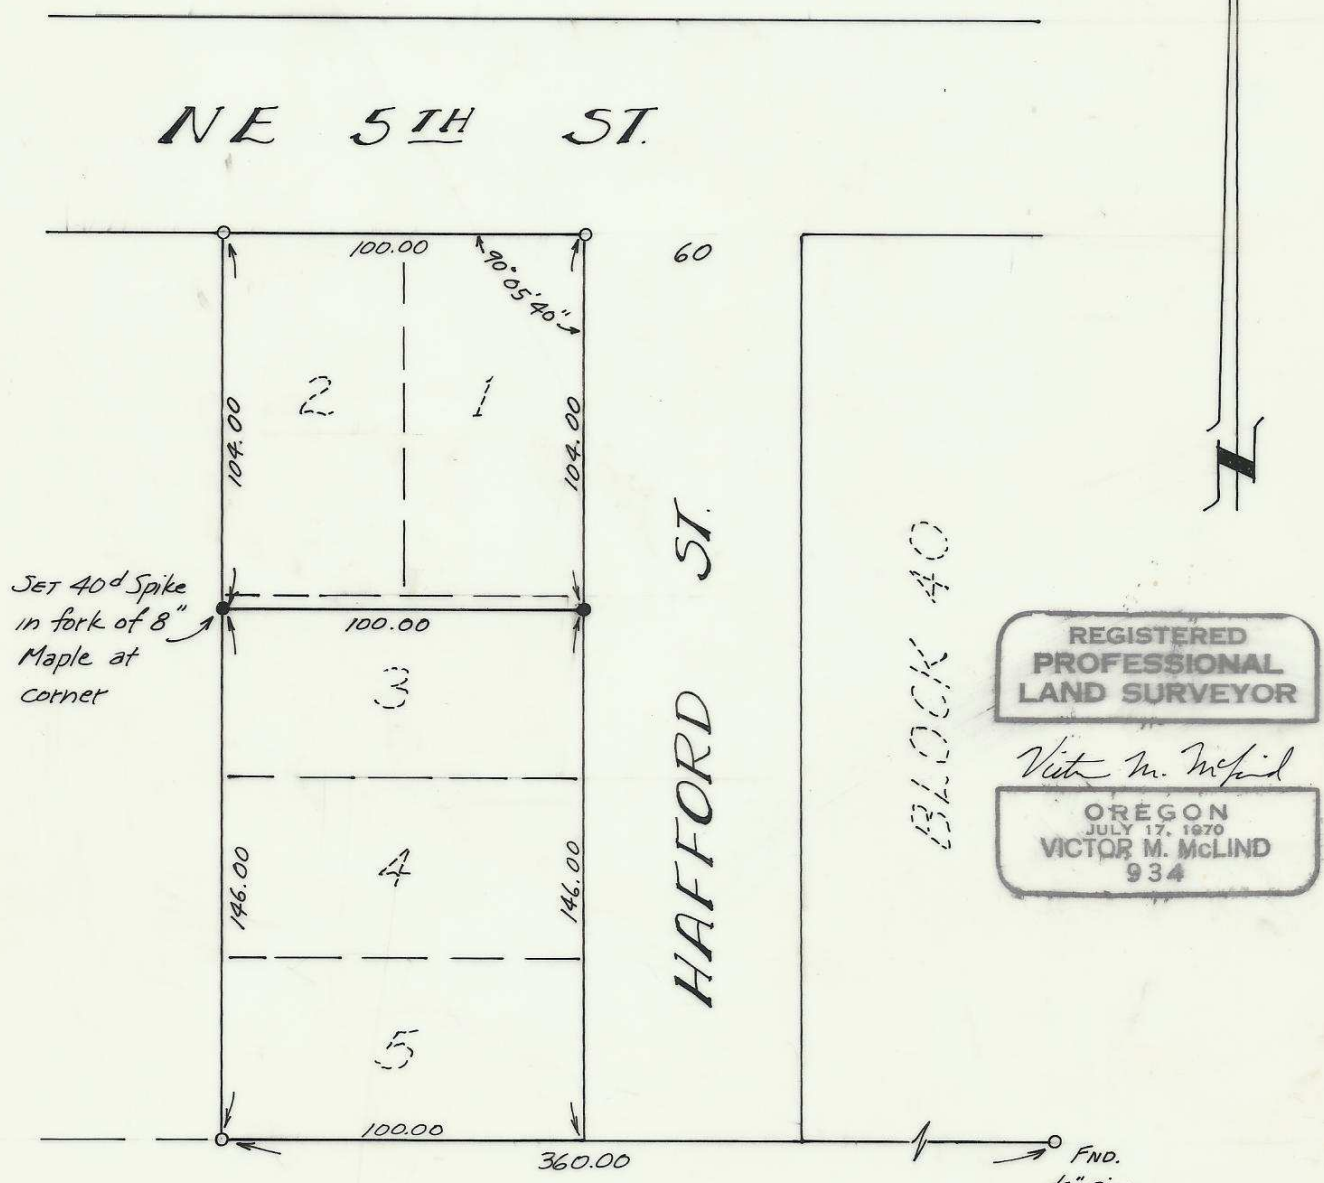

REGISTERED  
 PROFESSIONAL  
 LAND SURVEYOR

*Victor M. McInd*

OREGON  
 JULY 17, 1970  
 VICTOR M. McLIND  
 934

- LEGEND**
- — FOUND 5/8" IRON ROD, OR AS NOTED
  - — SET 5/8" IRON ROD, OR AS NOTED

RECEIVED BY  
 Umatilla County Surveyor  
 Date 12-81  
 Rec'd By BLS  
 No. S-139-Ax

NARRATIVE OF SURVEY

SURVEYED BY: Victor M. McLind, Route 3, Box 2, Milton-Freewater, OR 97862

SURVEYED FOR: Earl Karr

DATE OF SURVEY: November, 1981

LOCATION: N. W.  $\frac{1}{4}$  Sec. 1, T 5 N. R 35 E, in Block 41, Orig. Town of Freewater

MONUMENTS FOUND:  $\frac{5}{8}$ " iron rods at N.E. cor. Lot 1, N.W. cor. Lot 2, and S.W. cor. Lot 5.  $\frac{1}{2}$ " iron rod at S.E. cor. Lot 7, Bl. 40.

MONUMENTS SET:  $\frac{5}{8}$ " iron rods at N.E. cor. of the southerly 46 feet of Lot 3;  
40d spike in fork of an 8" maple at N.W. cor. of southerly 46 feet of Lot 3

PURPOSE OF SURVEY: to mark the north line of the southerly 46 feet of Lot 3, Bl. 41,  
Orig. Town of Freewater.

COMMENTS:

RECEIVED BY  
Umatilla County Surveyor  
Date 12-81  
Rec'd by BLS  
No. 3-139

