


5/15/70

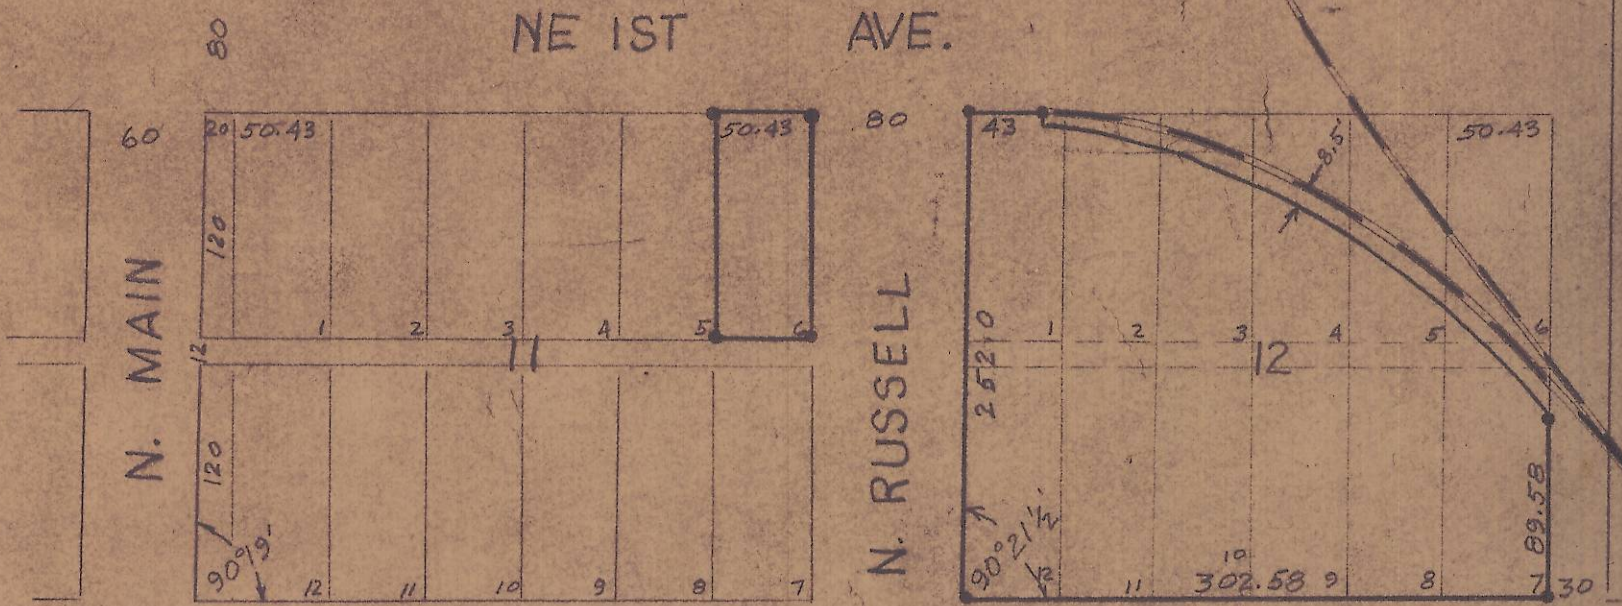

797.32 = 5.37' long

SURVEY FOR
 PENDLETON GRAIN GROWERS
 NORTH MILTON ADDITION
 MILTON, FREEWATER

Scale 1"=100'

Aug. 9, 1970



Guy W. Streamer, Jr.
 PROFESSIONAL ENGINEER



11+2 NORTH MILTON 350' DIA

Survey S-157
 536