


SEE STAEBLER SURVEY  
RECORDED P-77C

**LEGAL DESCRIPTION**

Beginning at the Northwest corner of the Northeast Quarter of the Southwest Quarter of Section 1, Township 5 North, Range 35; thence South 1272.00 feet; thence East 30 feet to a 1/2" iron pin which is the point of beginning for this description; thence East 300.66 feet to a point; thence South 434.58 feet to a 1/2" iron pin; thence West 300.66 feet to a 1/2" iron pin; thence North 434.58 feet to the point of beginning.  
EXCEPTING that portion beginning at the Northwest corner of the Northeast Quarter of the Southwest Quarter of Section 1, Township 5 North, Range 35; thence South 1176.58 feet; thence East 30 feet to a 1/2" iron pipe which is the point of beginning for this description; thence East 300.66 feet to a 1/2" iron pin; thence South 230 feet to a 1/2" iron pin; thence West 300.66 feet to a 1/2" iron pin thence North 230 feet to the point of beginning.

**NOTES:**

1/2" iron pins were originally set on the Bridgewater Tract and on the Louisi Tract, as referenced by the deeds Bridgewater to Louisi, Book 274/654 and Reel 89/678.  
Bridgewater records turned up a copy of a survey completed by Wayne Harris, 12/15/57, showing 1/2" iron pins set. None were found. His East-West dimensions show 300.75'. His North-South dimensions coincide with the deeds.

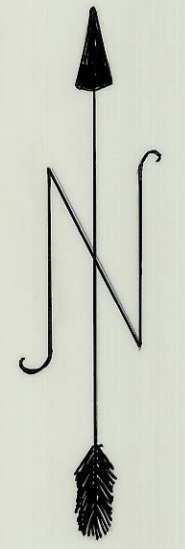

SCALE 1"=100'

"R" = RECORD "M" = MEASURED

**SURVEYOR'S CERTIFICATE**

THIS MAP CORRECTLY REPRESENTS A SURVEY MADE BY ME OR UNDER MY DIRECTION IN CONFORMANCE WITH THE REQUIREMENTS OF THE SURVEY RECORDING ACT IN \_\_\_\_\_, 19\_\_\_\_.

Certificate No. 12696

**AUDITOR'S CERTIFICATE**

FILED FOR RECORD THIS \_\_\_\_\_ DAY OF \_\_\_\_\_, 19\_\_\_\_ AT \_\_\_\_\_ IN BOOK \_\_\_\_\_ AT PAGE \_\_\_\_\_ AT THE REQUEST OF \_\_\_\_\_

COUNTY AUDITOR \_\_\_\_\_

RECEIVED BY  
Umatilla County Surveyor  
Date 9-2-83  
Rec'd By bc  
No. 83-1165-B

REGISTERED  
PROFESSIONAL  
LAND SURVEYOR

*Ronald L. Munns*  
OREGON  
JUNE 18, 1976  
RONALD L. MUNNS  
1059

**RONALD L. MUNNS**  
LICENSED LAND SURVEYOR

2nd and W. Main Walla Walla, WA 99382 Phone 525-7180

Surveys	A SURVEY FOR ELAINE WOLFF	
Descriptions		
Sub Divisions	Date <u>8/9/83</u>	No. <u>5617</u>
	Drawn By <u>DM</u>	
	Checked By <u>RLM</u>	