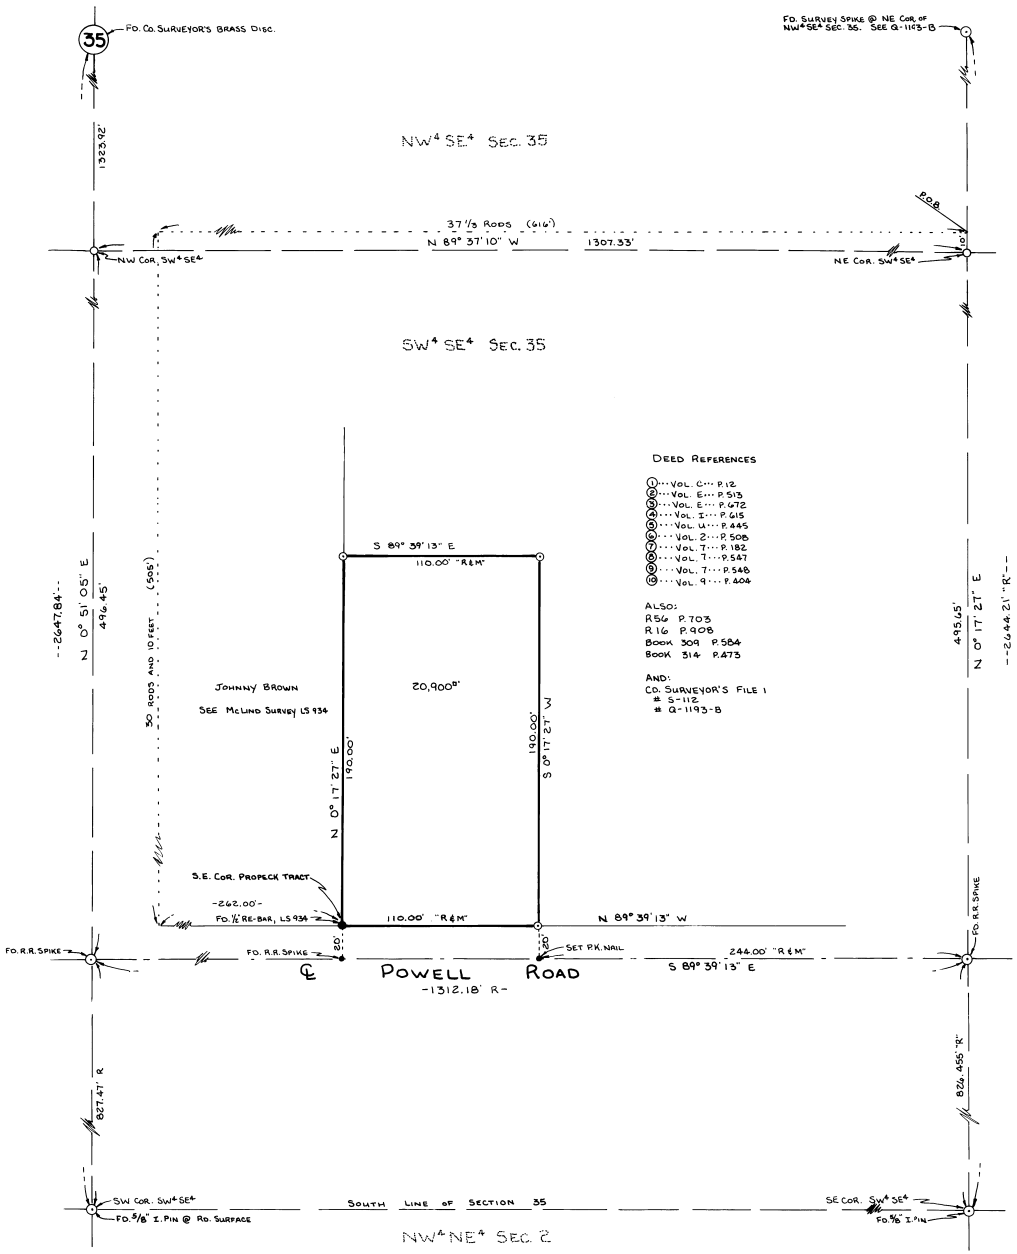

LEGAL DESCRIPTION

Beginning at a point 10 feet North of center of Southeast Quarter of Section 35, T 6 N, R 35 E.W.M.; thence West 37-1/3 rods; thence South 30 rods and 10 feet; thence East 262 feet to Southeast corner of that tract conveyed to W.A. Propeck, et ux, by Deed recorded in Book 266, page 561, Deed Records, said point being the true point of beginning for this description; thence continuing East 110 feet; thence North at right angles, 210 feet; thence West at right angles 110 feet to a point in East line of Propeck Tract, said point being 210 feet North of the point of beginning; thence South 210 feet to the point of beginning.

SUBJECT TO any and all water rights of way and roads.

All being East of the Willamette Meridian, Umatilla County, Oregon.

SCALE 1" = 50'

SW4 SE4 SECTION 35, T6N...R35E.W.M.

⊙ = 1/2" I. PIN WITH YELLOW CAP SET
○ = CALC. PT.; NOTHING FD., NOTHING SET
"R" = RECORD "M" = MEASURED

BASIS OF BEARINGS: S 89° 39' 13" E ON ℄ POWELL RD. AS PER CO. SURVEYOR'S FILE NO. S-112.

SURVEYOR'S CERTIFICATE

THIS MAP CORRECTLY REPRESENTS A SURVEY MADE BY ME OR UNDER MY DIRECTION IN CONFORMANCE WITH THE REQUIREMENTS OF THE SURVEY RECORDING ACT IN _____, 19____.

Certificate No. 12696

AUDITOR'S CERTIFICATE

FILED FOR RECORD THIS _____ DAY OF _____, 19____ AT _____ IN BOOK _____ AT PAGE _____ AT THE REQUEST OF _____

COUNTY AUDITOR

RECEIVED BY
Umatilla County Surveyor
Date 8-5-84
Fee KA
No. 86-103-B

REGISTERED PROFESSIONAL LAND SURVEYOR
OREGON
JULY 14, 1972
RONALD L. MUNNS

Ronald L. Munns

RONALD L. MUNNS
LICENSED LAND SURVEYOR
2nd and W. Main Walla Walla, WA 99362 Phone 525-7180

Surveys
Descriptions
Sub Divisions

A SURVEY FOR NORM SAAGER

Date OCTOBER 1985
Drawn By RM
Checked By RLM

No. 5823