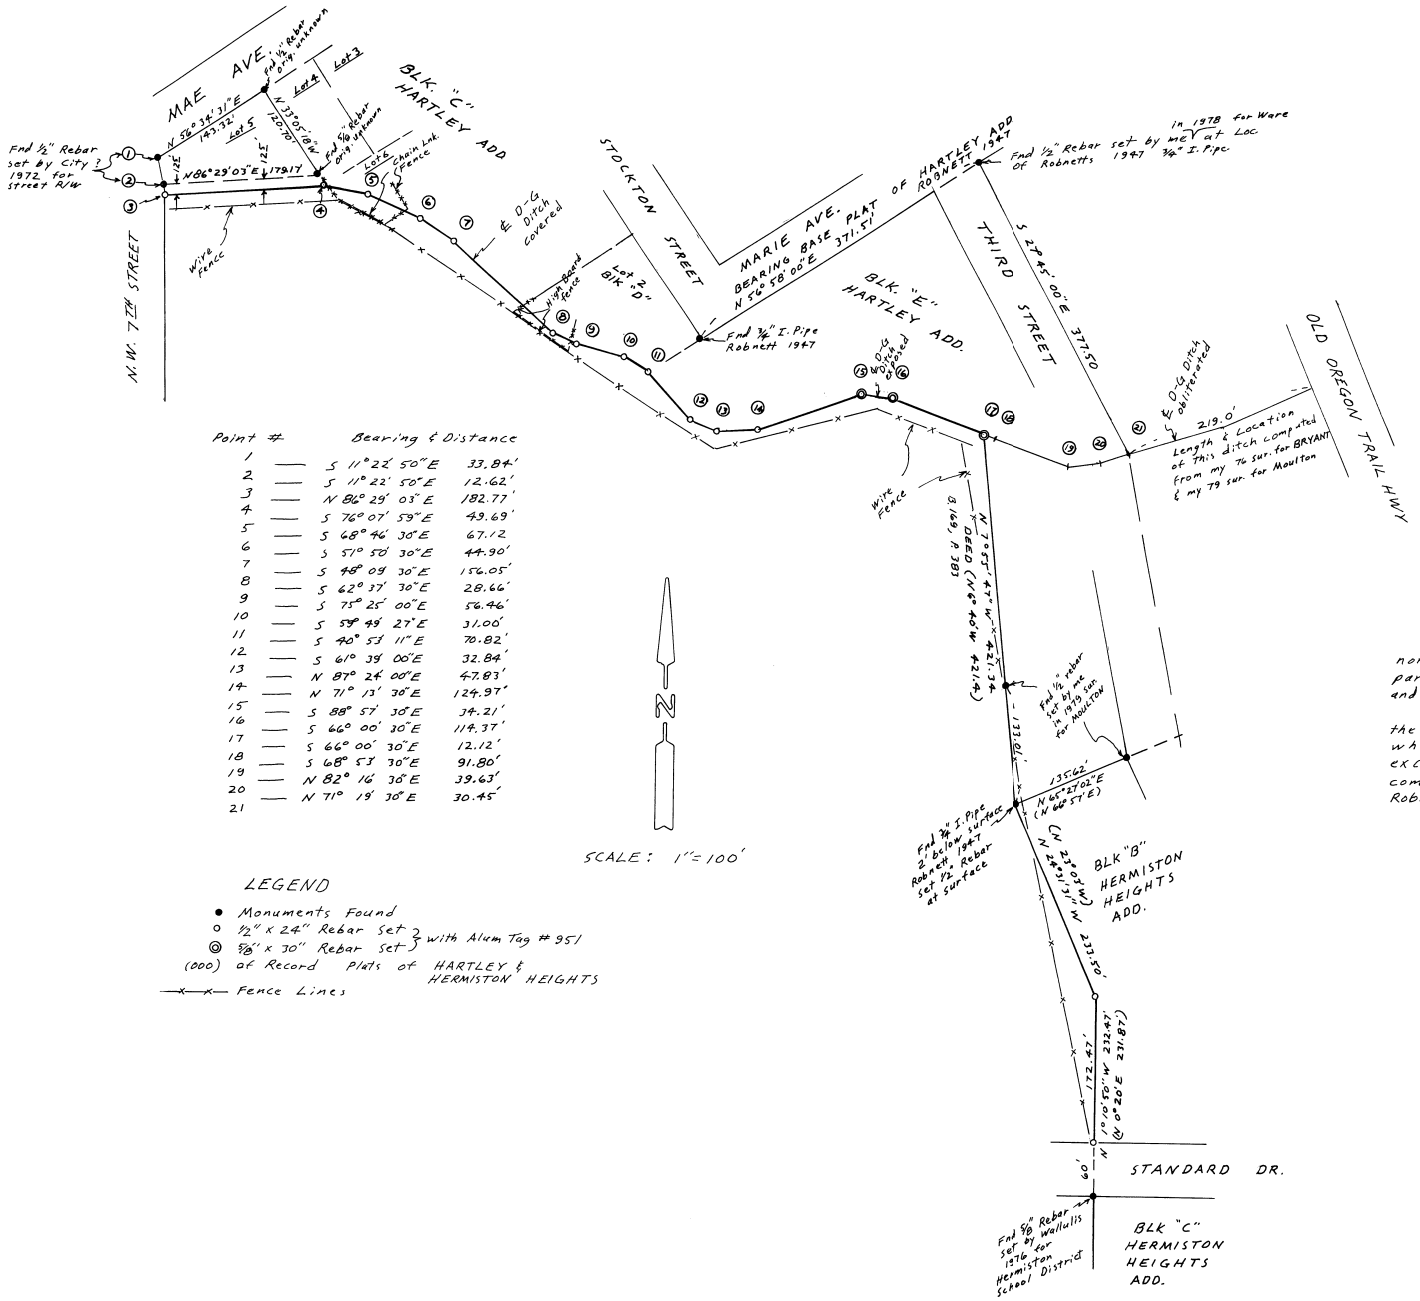

Point #		Bearing & Distance	
1	—	S 11° 22' 50" E	33.84'
2	—	S 11° 22' 50" E	12.62'
3	—	N 86° 29' 03" E	182.77'
4	—	S 76° 07' 59" E	49.69'
5	—	S 68° 46' 30" E	67.12
6	—	S 51° 50' 30" E	44.90'
7	—	S 48° 09' 30" E	156.05'
8	—	S 62° 37' 30" E	28.66'
9	—	S 75° 25' 00" E	56.46'
10	—	S 58° 49' 27" E	31.00'
11	—	S 40° 53' 11" E	70.82'
12	—	S 61° 39' 00" E	32.84'
13	—	N 87° 24' 00" E	47.83'
14	—	N 71° 13' 30" E	124.97'
15	—	S 88° 57' 30" E	34.21'
16	—	S 66° 00' 30" E	114.37'
17	—	S 66° 00' 30" E	12.12'
18	—	S 68° 53' 30" E	91.80'
19	—	N 82° 16' 30" E	39.63'
20	—	N 71° 19' 30" E	30.45'
21			

LEGEND

- ● Monuments Found
- o ½" x 24" Rebar Set with Alum Tag # 951
- ◎ ⅝" x 30" Rebar Set with Alum Tag # 951
- (000) of Record Plats of HARTLEY & HERMISTON HEIGHTS
- —x—x— Fence Lines

NARRATIVE

The purpose of this survey is to stake the north and east lines of Rocky Heights School parcel described in Deed Recorded in B. 265, P. 382, and to show fence lines.

The north line of said parcel is the ℄ of the vacated concrete lined D-G Irrigation ditch which is either covered with dirt or obliterated except in the vicinity of points 15 & 16. I computed its location from corners found in Robnetts 1947 "HARTLEY ADD." Subdivision.

REGISTERED PROFESSIONAL LAND SURVEYOR
G. Dennis Edwards
OREGON JULY 16, 1971 G. DENNIS EDWARDS 951

RECEIVED
Umatilla County Surveyor
Records Book No. 5 Page 31-B

SURVEY FOR HERMISTON SCHOOL DISTRICT IN NE ¼ Sec. 10, T4N, R28E, W.M, UMATILLA COUNTY, OREGON.
5/29/87 Job # 5870401B

EDWARDS SURVEYING P.O. Box 763
567-3336 HERMISTON, OREGON