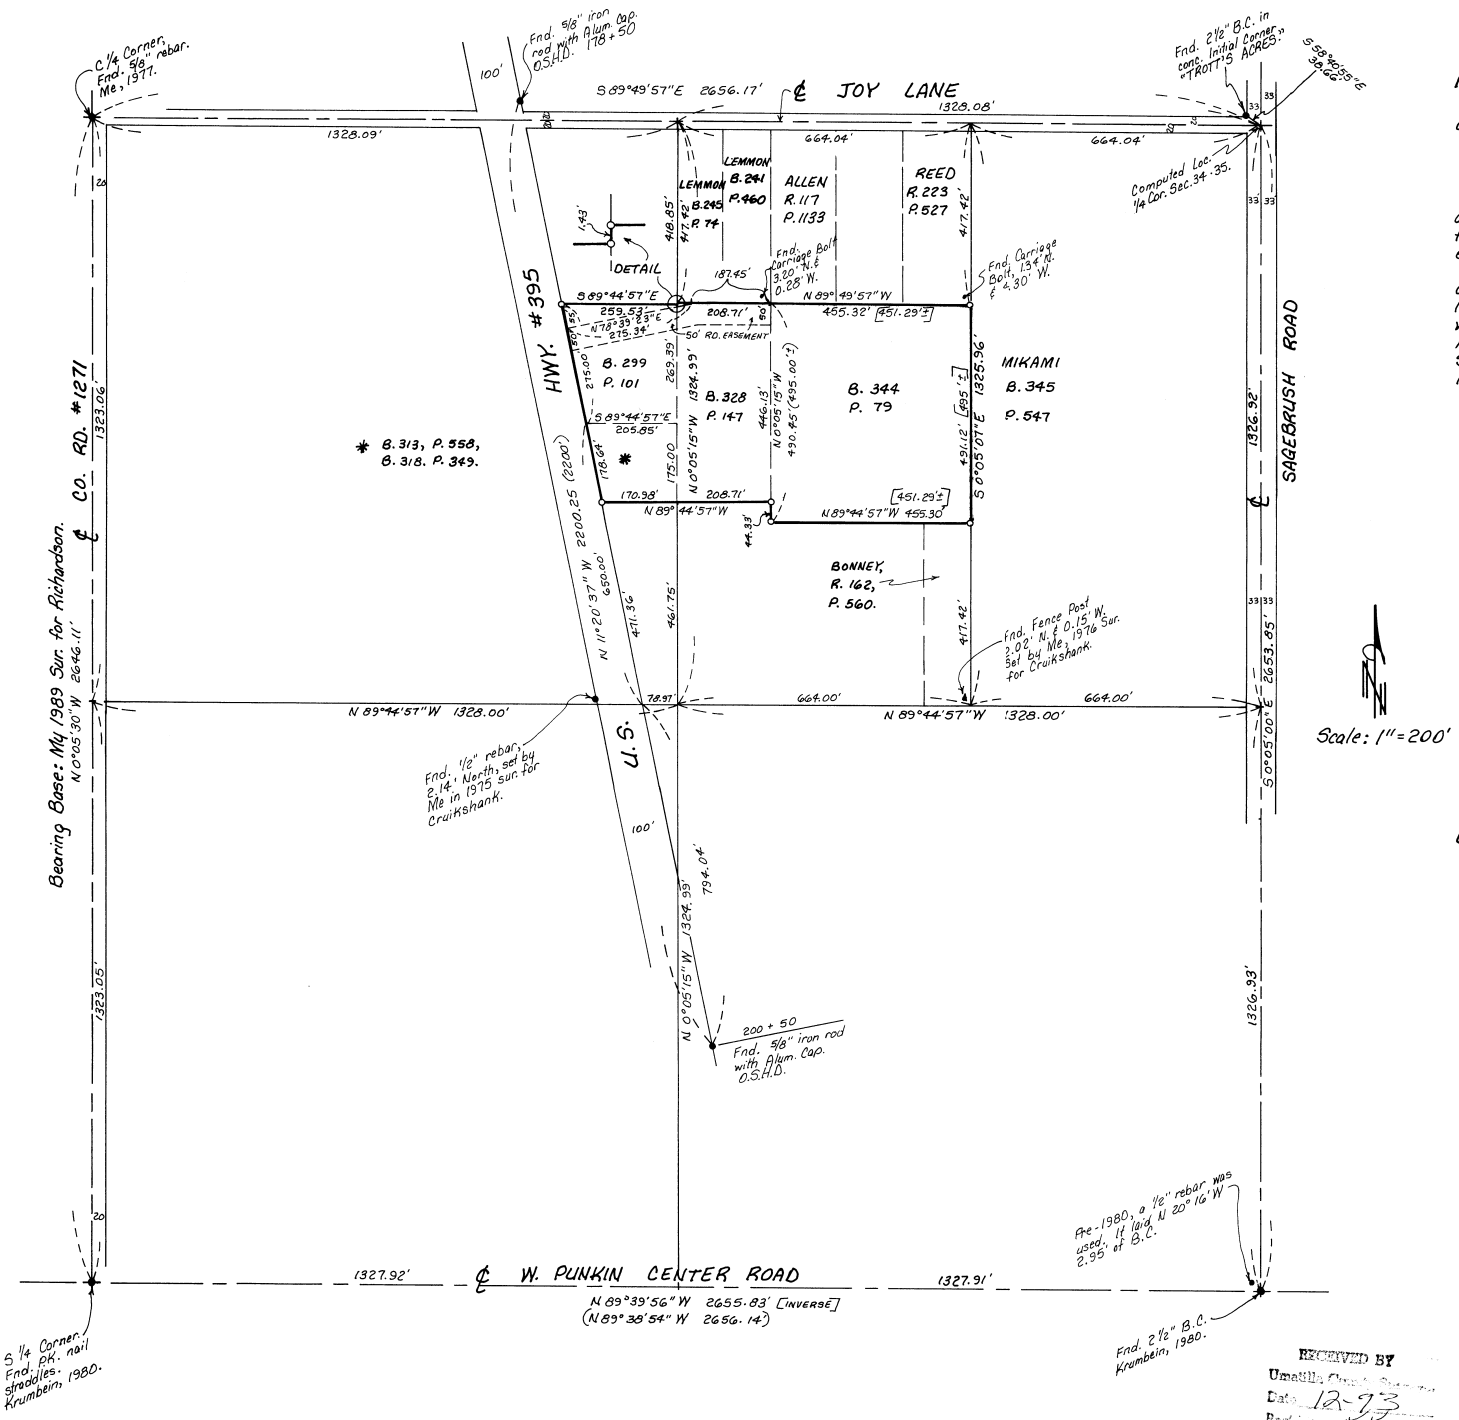

NARRATIVE:

The purpose of this survey is to stake the corners of Robert Butts' parcels:
Book 299, Page 101 (Tax Lot 701)
Book 328, Page 147 (Tax Lot 404)
Book 313, Page 558 } (Tax Lot 1201)
Book 318, Page 349 }
and Book 344, Page 79 (Tax Lot 405),
for the pending sale of T.L. 405 and to describe an easement into said Tax Lot.

I used Krumbein's Brass Cap corners at the S 1/4 cor. and the SE cor. of Section 34, which he set in 1980 - 2 to 3 feet South of the Section corners which were used before 1980. That's the main reason my E-W centerline of the SE 1/4 is now South of the E-W centerline as I surveyed it in 1975 for Cruikshank.

REGISTERED PROFESSIONAL LAND SURVEYOR
OREGON JULY 15, 1971
J. DENNIS EDWARDS
951

LEGEND:

- • Found monuments, as noted.
- ○ Set 5/8" x 30" rebar with plastic cap #951.
- (000) of Record.
- [000] Deed Records.

RECEIVED BY
Umatilla County Surveyor
Date 12-9-93
Recorded KK
No. 93-101-B

Survey for **ROBERT BUTTS**
In SE 1/4 Section 34, T5N, R28E, W.M.,
Umatilla County, Oregon
9/14/93 Job #5930906I
Edwards Surveying P.O. Box 763
567-3336 Hermiston, Oregon 97838