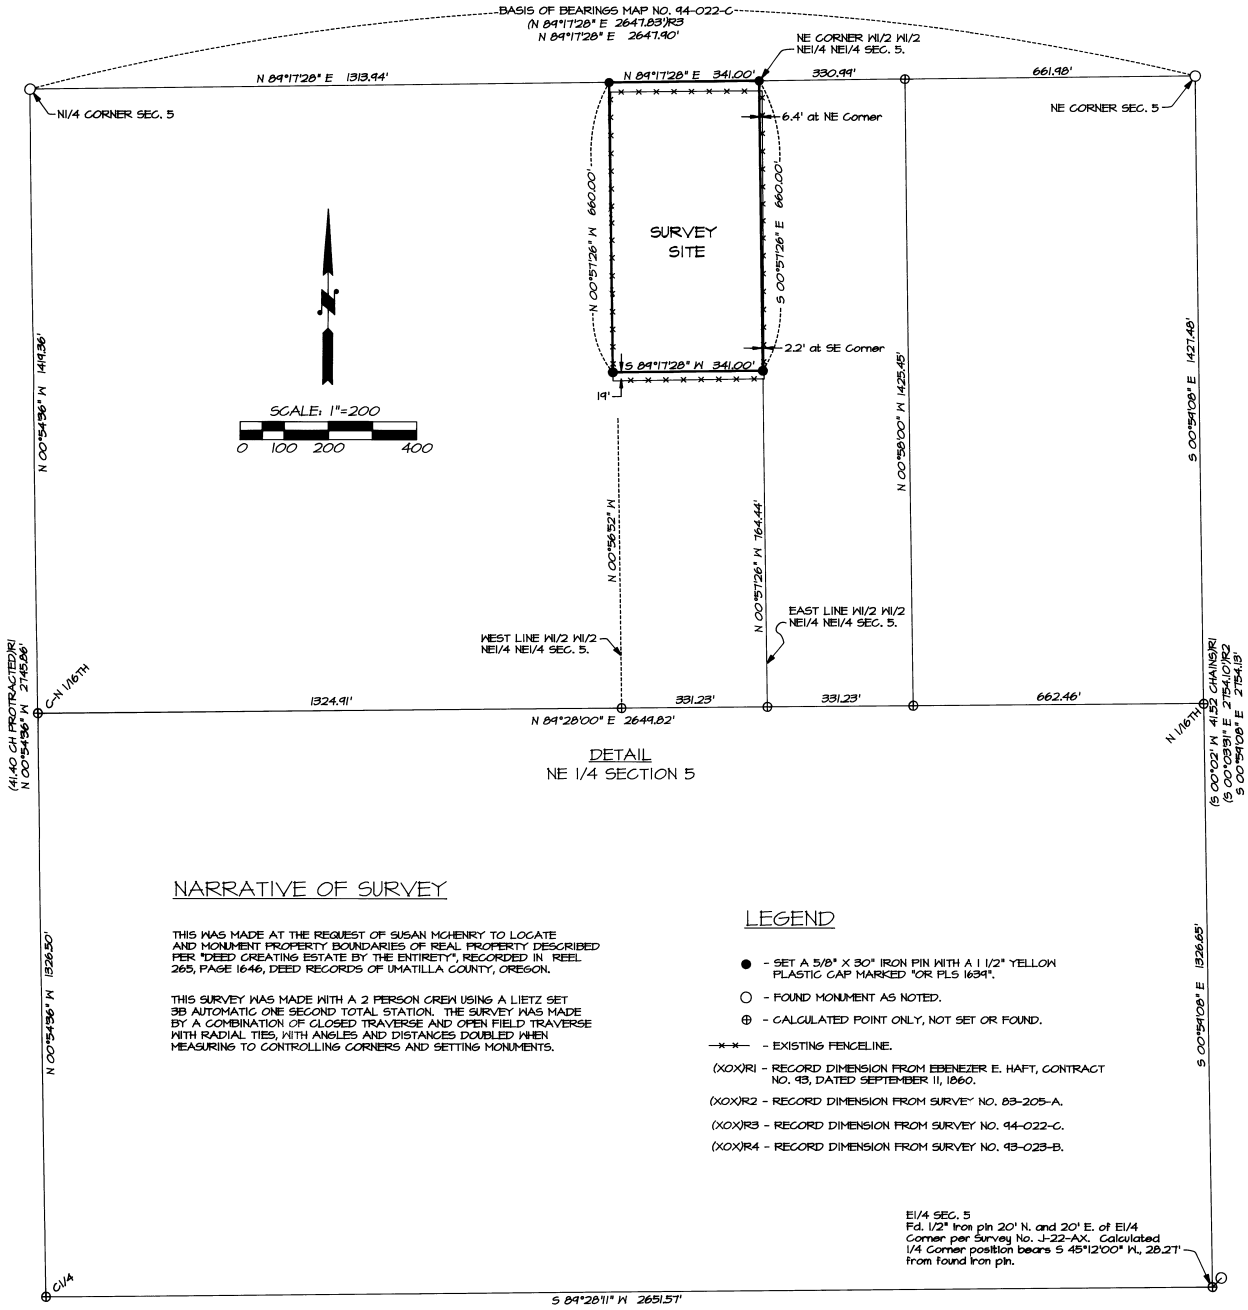

DETAIL
NE 1/4 SECTION 5

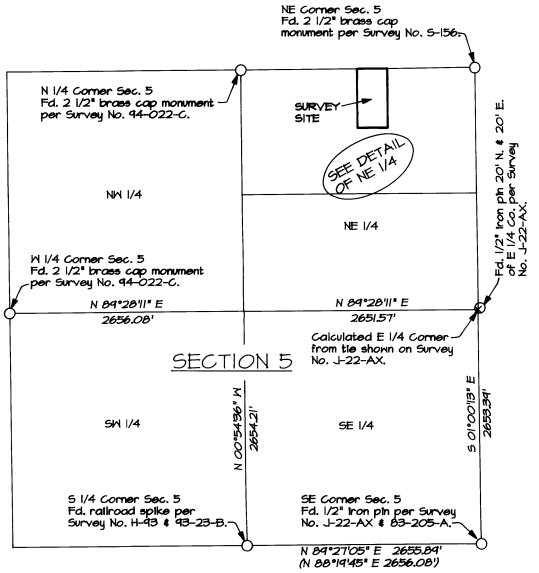

CONTROL DIAGRAM
SCALE: 1 INCH = 1000 FEET

NARRATIVE OF SURVEY

THIS WAS MADE AT THE REQUEST OF SUSAN MCHENRY TO LOCATE AND MONUMENT PROPERTY BOUNDARIES OF REAL PROPERTY DESCRIBED PER "DEED CREATING ESTATE BY THE ENTIRETY", RECORDED IN REEL 265, PAGE 1646, DEED RECORDS OF UMATILLA COUNTY, OREGON.

THIS SURVEY WAS MADE WITH A 2 PERSON CREW USING A LIETZ SET 3B AUTOMATIC ONE SECOND TOTAL STATION. THE SURVEY WAS MADE BY A COMBINATION OF CLOSED TRAVERSE AND OPEN FIELD TRAVERSE WITH RADIAL TIES, WITH ANGLES AND DISTANCES DOUBLED WHEN MEASURING TO CONTROLLING CORNERS AND SETTING MONUMENTS.

LEGEND

- ● - SET A 5/8" X 30" IRON PIN WITH A 1 1/2" YELLOW PLASTIC CAP MARKED "OR PLS 1639".
- ○ - FOUND MONUMENT AS NOTED.
- ⊕ - CALCULATED POINT ONLY, NOT SET OR FOUND.
- -x-x- - EXISTING FENCELINE.
- (XOX)R1 - RECORD DIMENSION FROM EBENEZER E. HAFT, CONTRACT NO. 93, DATED SEPTEMBER 11, 1860.
- (XOX)R2 - RECORD DIMENSION FROM SURVEY NO. 83-205-A.
- (XOX)R3 - RECORD DIMENSION FROM SURVEY NO. 94-022-C.
- (XOX)R4 - RECORD DIMENSION FROM SURVEY NO. 93-023-B.

REGISTERED PROFESSIONAL LAND SURVEYOR
William L. Hanley
OREGON
JULY 14, 1978
WILLIAM L. HANLEY
1639
RENEWS 6/30/97

RECEIVED BY
Umatilla County Surveyor
5-96
KK
No. 96-86-B

VMCHENRY

WILLIAM R. WELLS, PLS
357 N.E. HWY. 11
P.O. BOX 1696
PENDLETON, OR 97801
PHONE:(541) 276-6362

DATE: 5/1/96	DR. BY: DMT
CK. BY: WRW	NO: 96-381

PROJECT:
PROPERTY SURVEY FOR:
WILLIAM & SUSAN MCHENRY

LOCATED IN THE NORTHEAST QUARTER OF SECTION 5, TOWNSHIP 4 NORTH, RANGE 28, W.M., UMATILLA COUNTY, OREGON.

File