



RECORD OF SURVEY

FEBRUARY, 2000

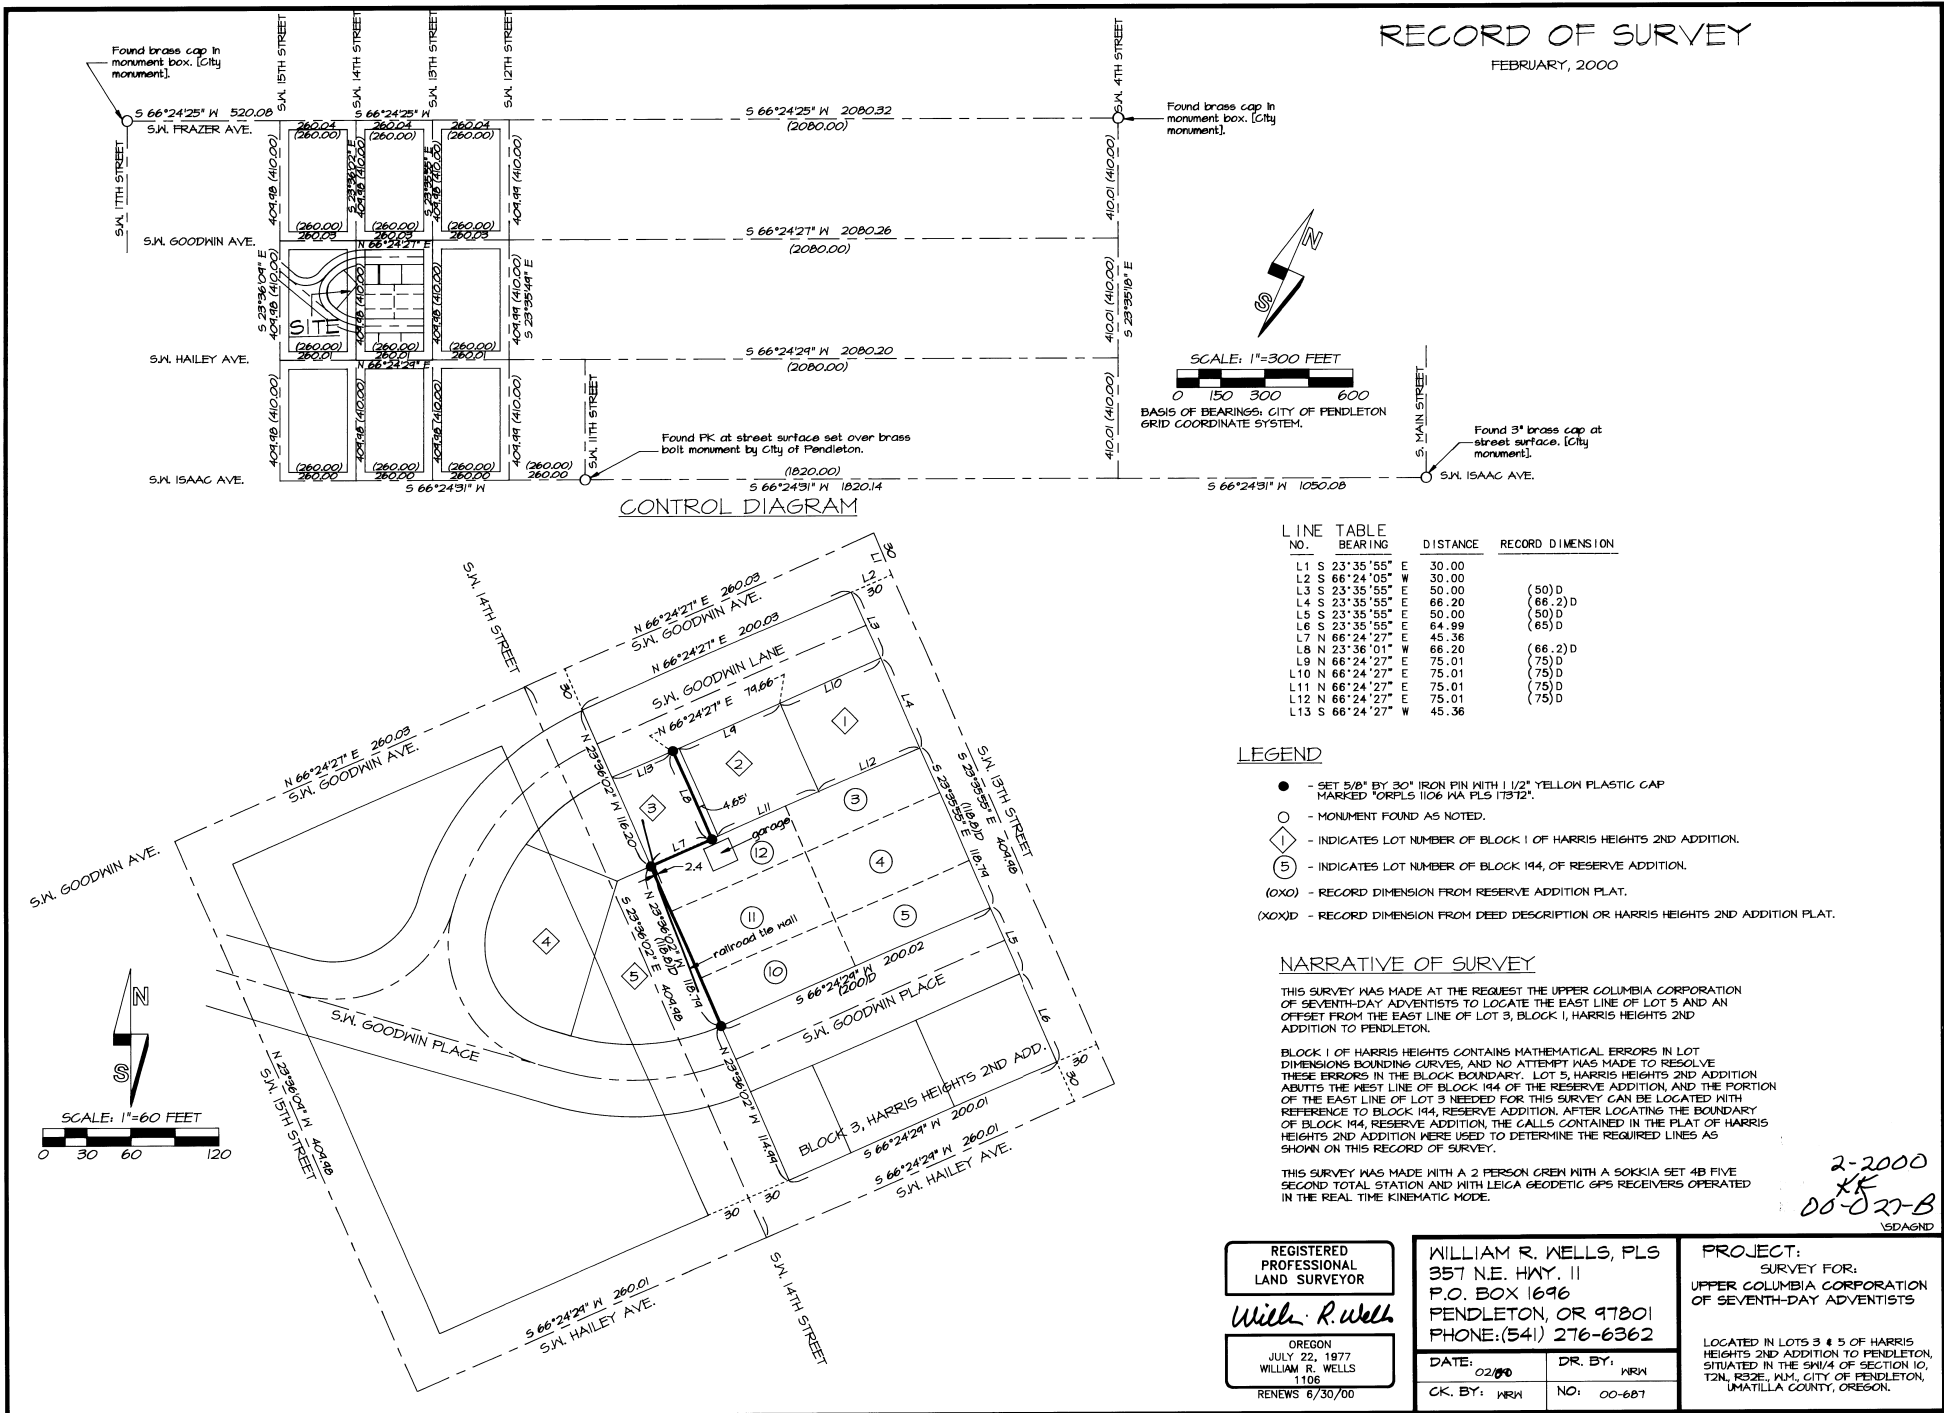

CONTROL DIAGRAM

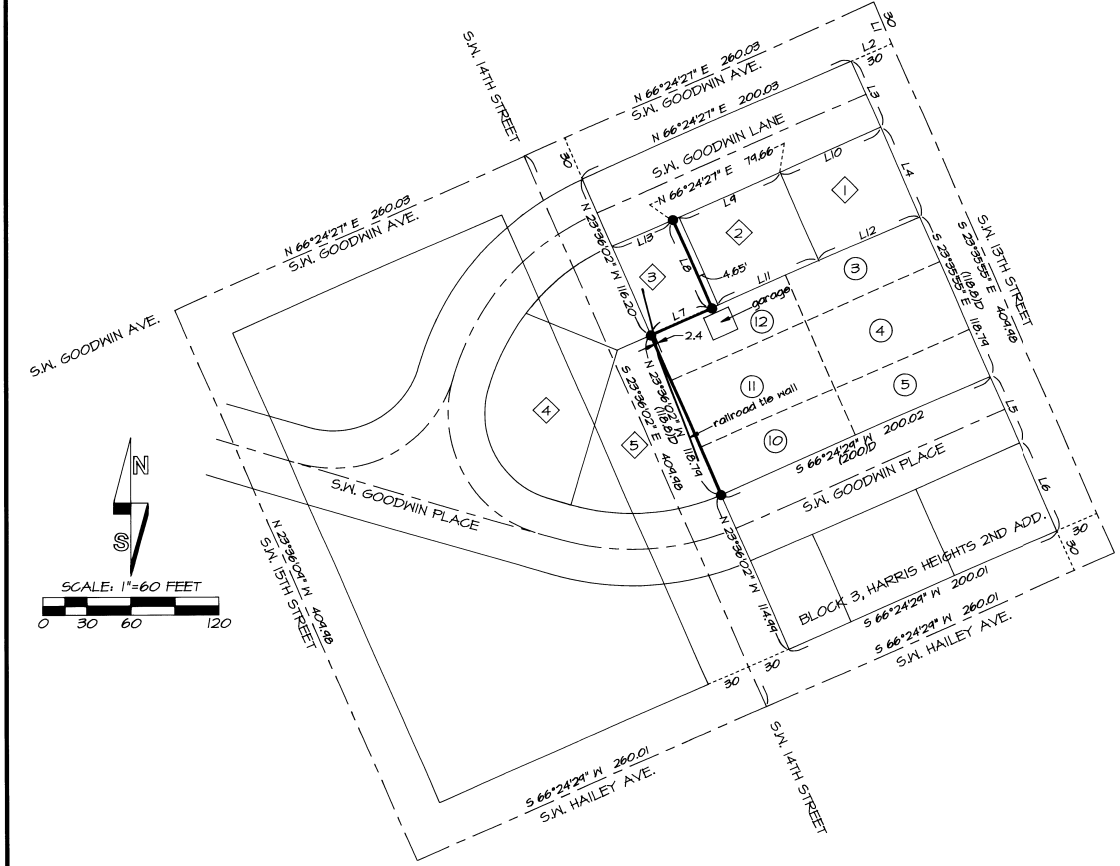

LINE NO.	BEARING	DISTANCE	RECORD DIMENSION
L1	S 23° 35' 55" E	30.00	
L2	S 66° 24' 05" W	30.00	
L3	S 23° 35' 55" E	50.00	(50) D
L4	S 23° 35' 55" E	66.20	(66.2) D
L5	S 23° 35' 55" E	50.00	(50) D
L6	S 23° 35' 55" E	64.99	(65) D
L9	N 66° 24' 27" E	75.01	(75) D
L10	N 66° 24' 27" E	75.01	(75) D
L11	N 66° 24' 27" E	75.01	(75) D
L12	N 66° 24' 27" E	75.01	(75) D
L13	S 66° 24' 27" W	45.36	(45.36) D

LEGEND

- - SET 5/8" BY 30" IRON PIN WITH 1/2" YELLOW PLASTIC CAP MARKED "ORPLS 1106 WA PLS 17312".
- - MONUMENT FOUND AS NOTED.
- ◇ - INDICATES LOT NUMBER OF BLOCK 1 OF HARRIS HEIGHTS 2ND ADDITION.
- ⑤ - INDICATES LOT NUMBER OF BLOCK 194, OF RESERVE ADDITION.
- (OXO) - RECORD DIMENSION FROM RESERVE ADDITION PLAT.
- (XOX) - RECORD DIMENSION FROM DEED DESCRIPTION OR HARRIS HEIGHTS 2ND ADDITION PLAT.

NARRATIVE OF SURVEY

THIS SURVEY WAS MADE AT THE REQUEST THE UPPER COLUMBIA CORPORATION OF SEVENTH-DAY ADVENTISTS TO LOCATE THE EAST LINE OF LOT 5 AND AN OFFSET FROM THE EAST LINE OF LOT 3, BLOCK 1, HARRIS HEIGHTS 2ND ADDITION TO PENDLETON.

BLOCK 1 OF HARRIS HEIGHTS CONTAINS MATHEMATICAL ERRORS IN LOT DIMENSIONS BOUNDING CURVES, AND NO ATTEMPT WAS MADE TO RESOLVE THESE ERRORS IN THE BLOCK BOUNDARY. LOT 5, HARRIS HEIGHTS 2ND ADDITION ABUTS THE WEST LINE OF BLOCK 194 OF THE RESERVE ADDITION, AND THE PORTION OF THE EAST LINE OF LOT 3 NEEDED FOR THIS SURVEY CAN BE LOCATED WITH REFERENCE TO BLOCK 194, RESERVE ADDITION. AFTER LOCATING THE BOUNDARY OF BLOCK 194, RESERVE ADDITION, THE CALLS CONTAINED IN THE PLAT OF HARRIS HEIGHTS 2ND ADDITION WERE USED TO DETERMINE THE REQUIRED LINES AS SHOWN ON THIS RECORD OF SURVEY.

THIS SURVEY WAS MADE WITH A 2 PERSON GREN WITH A SOKKIA SET 4B FIVE SECOND TOTAL STATION AND WITH LEICA GEODETIC GPS RECEIVERS OPERATED IN THE REAL TIME KINEMATIC MODE.

2-2000
 KF
 00-527-B
 VSDAGND

REGISTERED PROFESSIONAL LAND SURVEYOR

William R. Wells

OREGON
 JULY 22, 1977
 WILLIAM R. WELLS
 116
 RENEWS 6/30/00

WILLIAM R. WELLS, PLS
 357 N.E. HWY. 11
 P.O. BOX 1696
 PENDLETON, OR 97801
 PHONE: (541) 276-6362

DATE: 02/00 DR. BY: WRW
 CK. BY: WRW NO: 00-607

PROJECT:
 SURVEY FOR:
 UPPER COLUMBIA CORPORATION OF SEVENTH-DAY ADVENTISTS

LOCATED IN LOTS 3 & 5 OF HARRIS HEIGHTS 2ND ADDITION TO PENDLETON, SITUATED IN THE SW1/4 OF SECTION 10, T2N, R32E, W4E, CITY OF PENDLETON, UMATILLA COUNTY, OREGON.