


SCALE = 1" = 100'
 DATE : MAY 19, 1976
 SET 4-5/8" X 3'-0" PINS

FND. BRASS
 CAP
 27 26
 34 35

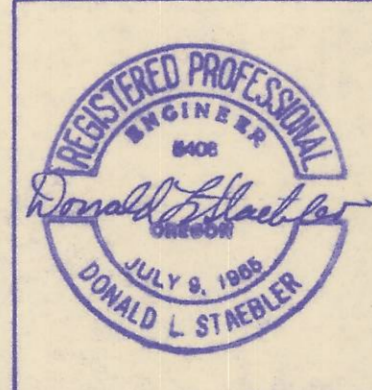

NORPA DEVELOPMENT INC. HERMISTON ORE.

SURVEY FOR: JIM LANGDON
 IN THE SE. 1/4 OF SECTION 27, T5N,
 R 28 E, W.M.

| | | | |
|------------|------------|-----------------|-------------------|
| DESIGN | CHKD. D.S. | SCALE 1" = 100' | DATE MAY 19, 1976 |
| DRAFT D.S. | APPD. D.S. | J.O. 76-022 | REV. DATE |

06-444-B