

**DETAIL**  
SCALE: 1"=75'


**NARRATIVE:**

THE PURPOSE OF THIS SURVEY IS TO STAKE THAT TRACT OF LAND DEEDED TO SHAWN AND CHANDRA ENG ON INSTRUMENT #2006-5060543, UMATILLA COUNTY DEED RECORDS, TO SEE HOW THE FENCES AND IMPROVEMENTS LIE.  
I SUBDIVIDED SECTION 6 IN A 2005 SURVEY FOR REA. THIS SURVEY AND THE BEARINGS ARE BASED ON THAT ONE. I DID NOT STAKE THE WEST LINE OF THIS TRACT WHICH IS THE RIGHT OF WAY THAT THE STATE BOUGHT WHEN THEY BUILT INTERSTATE 84.  
DATA WAS COLLECTED WITH TOPCON HIPER + GPS SYSTEM AND LOCALIZED ON MY 2005 SURVEY FOR REA.

REGISTERED  
PROFESSIONAL  
LAND SURVEYOR

*G. Dennis Edwards*

OREGON  
JULY 16, 1971  
G. DENNIS EDWARDS  
9 5 1  
RENEWS 12/31/2007

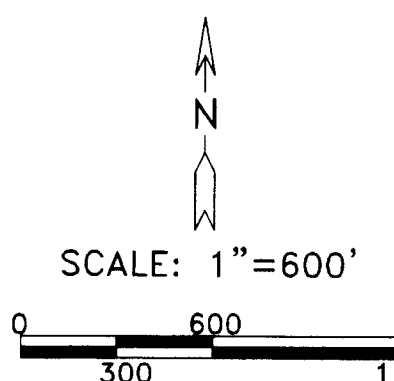

- LEGEND:**
- FOUND MONUMENTS AS NOTED
  - SET 5/8"X30" IRON REBAR WITH PLASTIC CAP #951
  - ⊙ SET PK NAIL
  - ⊕ COMPUTED LOCATION
  - (000) OF RECORD, PARTITION PLAT 1996-42
  - [000] OF RECORD, G.L.O. SURVEY

RECEIVED BY  
Umatilla County Surveyor

Date: 8-07  
Rec'd by: *kk*  
No. 07-225-B

SURVEY FOR DAN BAREMORE  
IN SW 1/4, NE 1/4, SEC. 6, T 3 N, R 29 E,  
W.M., UMATILLA COUNTY, OREGON  
06/25/2007 JOB #S0706109  
EDWARDS SURVEYING P.O. BOX 763  
541-567-3336 HERMISTON, OREGON 97838  
DRAWN BY NJF/JMC

07-225-B