

NARRATIVE:

THE PURPOSE OF THIS SURVEY IS TO STAKE THE NORTH LINE OF THE LANDS OF CAMPBELL MOTORS SO A FENCE CAN BE BUILT. KRUMBEIN SURVEYED SAID LINE IN A 2001 SURVEY FOR CAMPBELL. I FOUND THREE OF THE FOUR MONUMENTS HE SET IN THAT SURVEY AND RETRACED HIS SURVEY TO SET THE MISSING MONUMENT AT THE NORTHEAST CORNER OF THE PROPERTY. I ALSO SET AN ANGLE POINT IN THE LINE ABOUT 200 FEET WEST OF THE NORTHEAST CORNER AND TWO IRON RODS ON LINE NEAR THE NORTHWEST CORNER. I USED KRUMBEIN'S MONUMENTS FOR THIS SURVEY AND WAS CONCERNED ABOUT THE DIFFERENCES OF MEASURED AND RECORD DISTANCES BETWEEN MONUMENTS FROM HIS SURVEY AND MONUMENTS FROM WELLS' AND ROBINSON'S SURVEYS AS SHOWN. ROBINSON'S MONUMENTS ON THE EAST SIDE OF CAMPBELL'S PROPERTY HAVE BEEN OBLITERATED BUT THE LOCATION OF CAMPBELL'S NORTHEAST CORNER WAS CONFIRMED BY THE COMPUTED DISTANCE FROM THERE TO THE MOST SOUTHERLY NORTHWEST CORNER OF WALMART'S PROPERTY AS SURVEYED BY ROBINSON.


REGISTERED
PROFESSIONAL
LAND SURVEYOR

G. Dennis Edwards

OREGON
JULY 16, 1971
G. DENNIS EDWARDS
9 5 1
RENEWS 12/31/2007

LINE TABLE:

L1	SOUTH 8.69' (SOUTH 8.69')
L2	WEST 10.00' (WEST 10.00')
L3	S 19°48'38" E 1.19'
L4	S 1°10'16" W 29.20' [SOUTH 29.00']

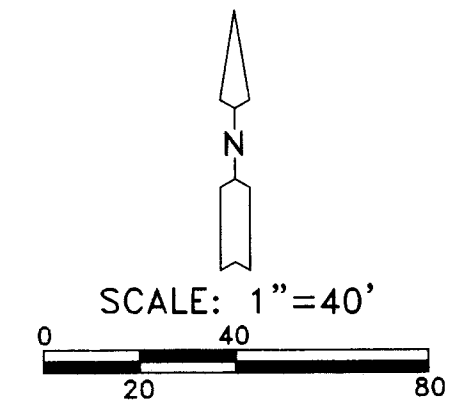

- LEGEND:**
- MONUMENTS FOUND AS NOTED OR
 - Ⓐ KRUMBEIN 2001 SURVEY FOR CAMPBELL
 - SET 5/8"X30" IRON REBAR WITH PLASTIC CAP #951
 - ⊙ COMPUTED LOCATION
 - (000) OF RECORD, KRUMBEIN 2001 SURVEY FOR CAMPBELL
 - [000] OF RECORD, ROBINSON 1999 SURVEY FOR PACIFIC LAND

MAP FOR CAMPBELL MOTORS
IN SW 1/4, SW 1/4, SEC. 2, T 4 N,
R 28 E, W.M., UMATILLA COUNTY, OREGON
08/13/2007 JOB #S0708134
EDWARDS SURVEYING P.O. BOX 763
541-567-3336 HERMISTON, OR 97838
DRAWN BY JMC

07-247-B
Umatilla County Surveyor
Date 8-07
Drawn by KK
07-247-B