


BASIS OF BEARINGS
 The centerline of SW 2nd
 being N89°22'44"W as
 per survey Q-925-C

A SURVEY OF LOTS 11-13
 BLOCK 6, ORIGINAL TOWN
 CITY OF PILOT ROCK, OREGON

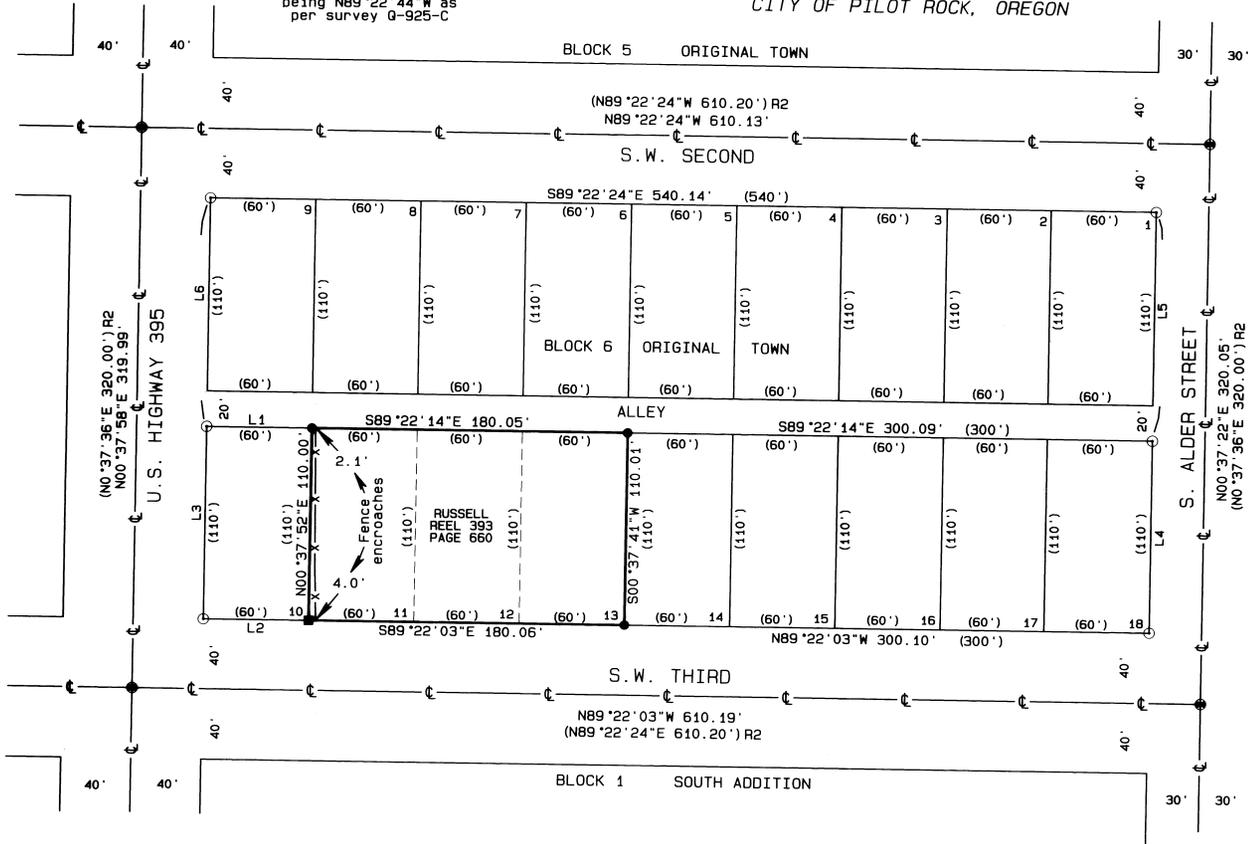

NARRATIVE OF SURVEY

This survey was performed at the request of Mr. Dave Russell. The purpose of the survey was to monument the boundaries of Lots 11 - 13 as shown in preparation for construction activities.

I established the boundaries for these lots based on the monumentation at the street intersections. Those monuments were set in 1976 under survey Q-925-C and have been used for the control of the surveys in the Original Town, North and South Additions to Pilot Rock since that date.

To calculate the lot locations I laid out the streets and alley at record dimension based on the original plat and then calculated the lot corners using proportionate distances.

REGISTERED
 PROFESSIONAL
 LAND SURVEYOR
Stephen K. Haddock
 OREGON
 JULY 9, 2001
 STEPHEN K. HADDOCK
 56299LS
 RENEWS 6-30-09

LEGEND

- FOUND BRASS CAP IN A MONUMENT CASE FROM SURVEY Q-925-C
- SET A 5/8" x 24" IRON REBAR W/ A 1/8" ORANGE PLASTIC CAP STAMPED WTS AND 56295LS
- SET A PK NAIL WITH A 1/8" COPPER WASHER STAMPED WTS AND 56295LS IN A DRILL HOLE IN THE BEDROCK
- COMPUTED POINT
- (xxx) RECORD DIMENSIONS FROM R1
- R1 PLAT OF PILOT ROCK INCLUDING NORTH AND SOUTH ADDITIONS PLAT BOOK 1, PAGE 95
- R2 COUNTY SURVEY Q-925-C
- R3 COUNTY SURVEY 07-145-B

LINE TABLE

LINE No.	BEARING	DISTANCE
L1	S89°22'14"E	60.01'
L2	S89°22'03"E	60.02'
L3	N00°37'58"E	110.00'
L4	N00°37'22"E	110.02'
L5	N00°37'22"E	130.03'
L6	N00°37'58"E	129.99'

RECEIVED BY

Umatilla County Surveyor
 Date: 4-08
 Rec'd By: AK
 No.: 08-59-B

SURVEY FOR

Mr. Dave Russell
 64142 E. Birch Creek Road
 Pilot Rock, OR 97868

LOCATION: SE1/4, NE1/4, S17, T1S, R32E, W.M.,
 UMATILLA COUNTY, OREGON

PROJECT DATE: February 25, 2008

Project No. 07-32

SCALE: 1" = 50'

WITNESS TREE SURVEYING

Stephen K. Haddock, PLS
 P.O. Box 6
 Pilot Rock, Oregon 97868
 (541) 443-2922