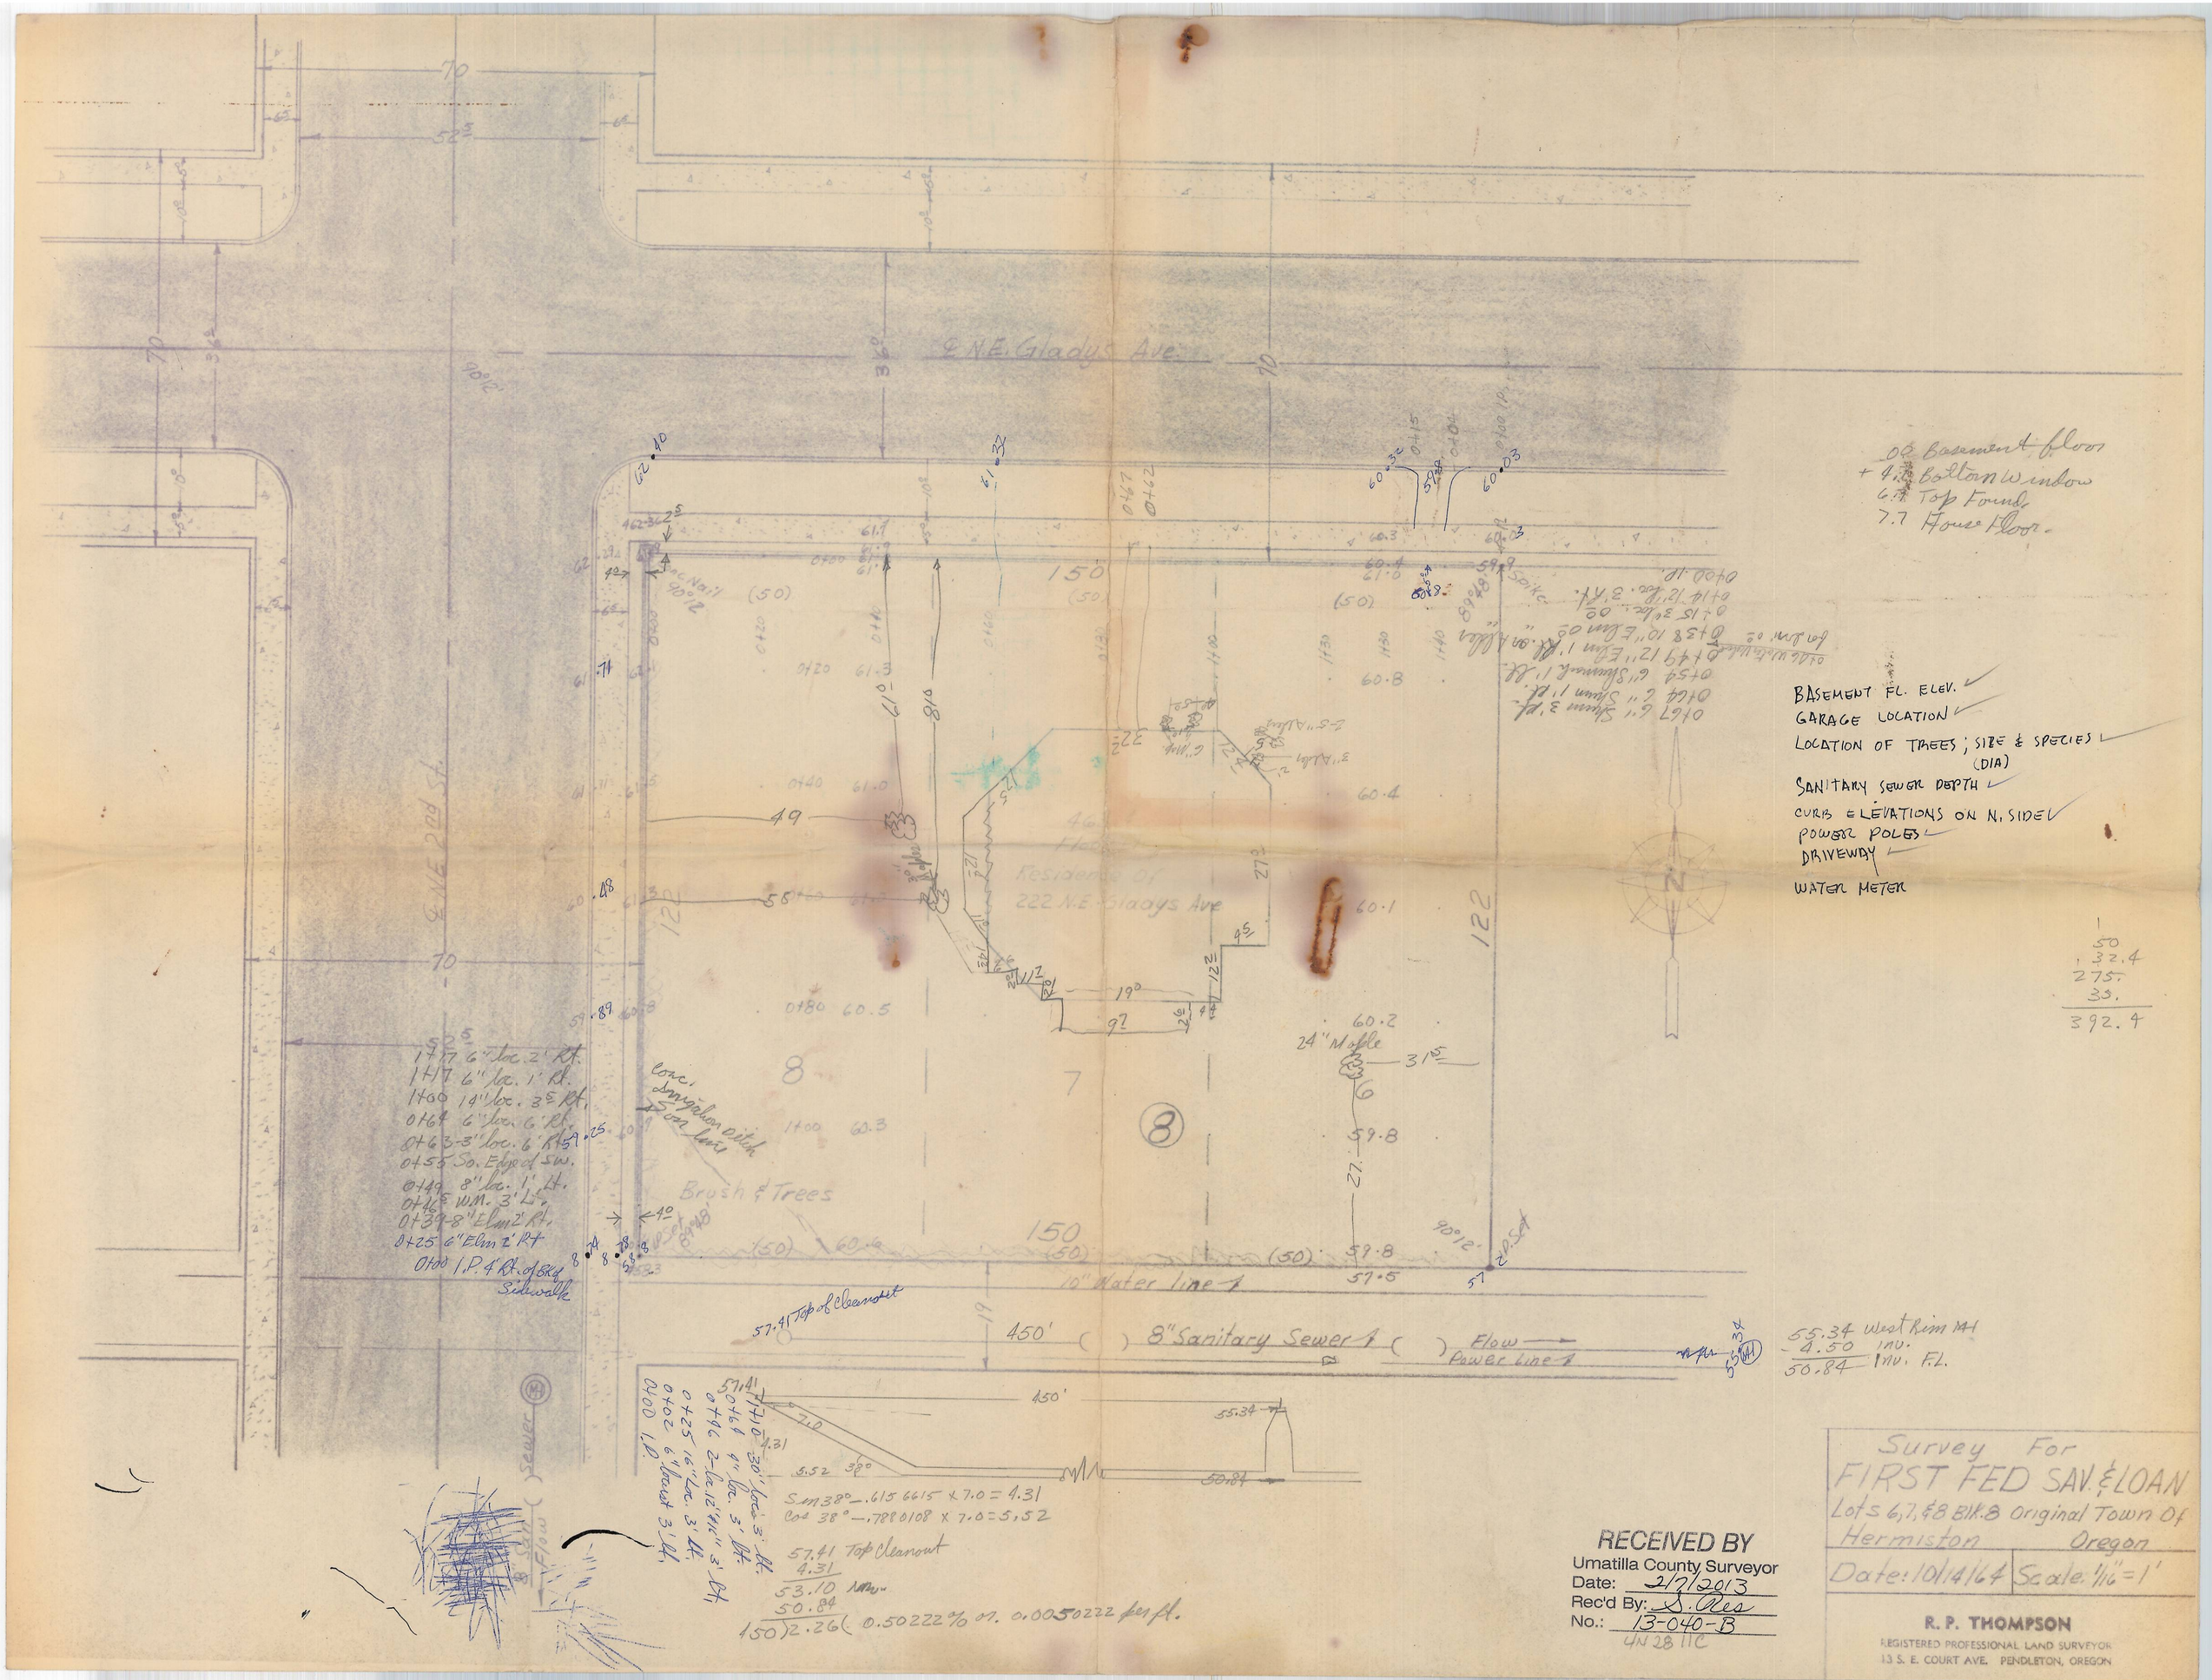


.00 Basement floor
+ 4.0 Bottom Window
6.7 Top Found.
7.7 House Floor.

BASEMENT FL. ELEV.
GARAGE LOCATION
LOCATION OF TREES; SIZE & SPECIES (DIA)
SANITARY SEWER DEPTH
CURB ELEVATIONS ON N. SIDE
POWER POLES
DRIVEWAY
WATER METER

50
32.4
275.
35.
392.4

1+17 6" loc. 2' Rt.
1+17 6" loc. 1' Rt.
1+00 14" loc. 3.5 Rt.
0+64 6" loc. 6' Rt.
0+63 3" loc. 6' Rt.
0+55 So. Edge of SW.
0+49 8" loc. 1' Lt.
0+46.5 W.M. 3' Lt.
0+39 8" Elm 2' Rt.
0+25 6" Elm 2' Rt.
0+00 I.P. 4' Rt. of BK of Sidewalk

57.41 Top of Cleanout
450'
55.34 West Rim M1
- 4.50 Inv.
50.84 Inv. F.L.

Sin 38° — .615 6615 × 7.0 = 4.31
Cos 38° — .7880108 × 7.0 = 5.52

57.41 Top Cleanout
4.31
53.10 Inv.
50.84
150)2.26( 0.50222% or 0.0050222 per ft.

RECEIVED BY
Umatilla County Surveyor
Date: 2/7/2013
Rec'd By: S. Res
No.: 13-040-B
4N 28 11C

Survey For
FIRST FED SAV. & LOAN
Lots 6, 7, & 8 Blk. 8 Original Town Of Hermiston Oregon
Date: 10/14/64 Scale: 1/16" = 1'

R. P. THOMPSON
REGISTERED PROFESSIONAL LAND SURVEYOR
13 S. E. COURT AVE. PENDLETON, OREGON