


ST.

MAIN

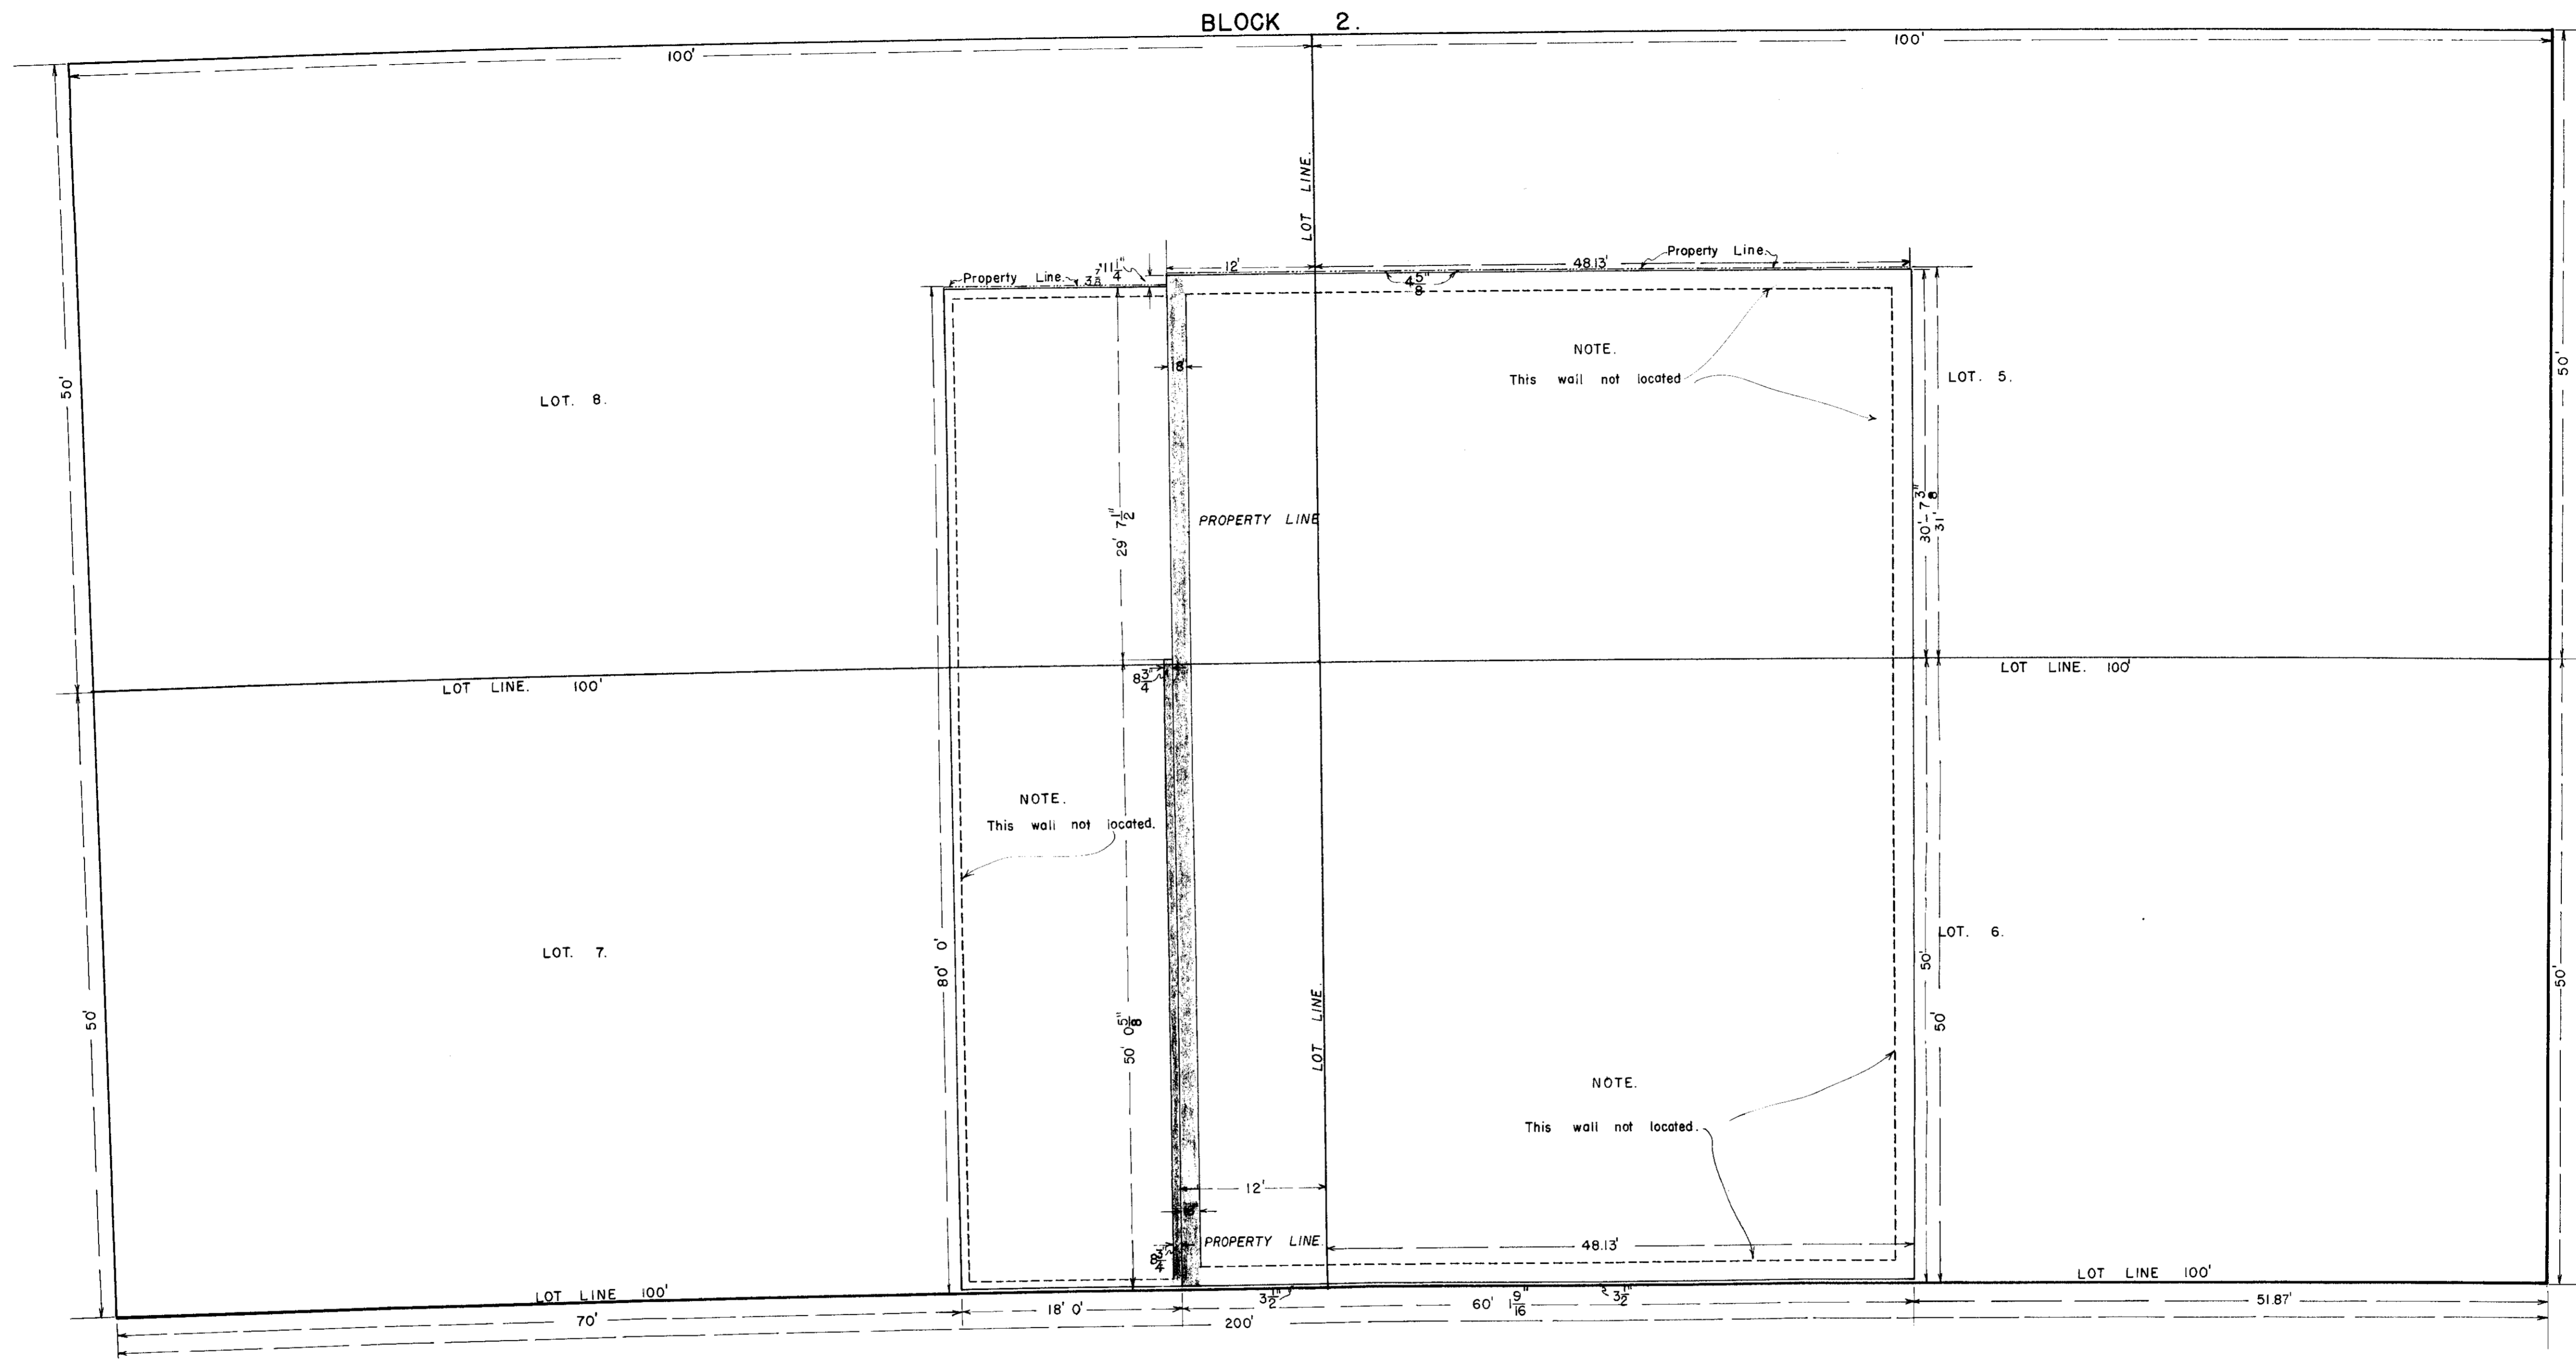

ST.

S. E. 1ST.

COURT

ST.

RECEIVED BY  
 Date: 4/24/2013  
 Recd By: [Signature]  
 No.: 13-140-B

[Signature]

MAP SHOWING THE LOCATION OF THE PROPERTY LINE BETWEEN THE LIVERMORE AND MURPHY BUILDINGS. IN THE CITY OF PENDLETON, ORIGINAL TOWN UMATILLA COUNTY, OREGON.

Scale 1/8" = 1'-0"