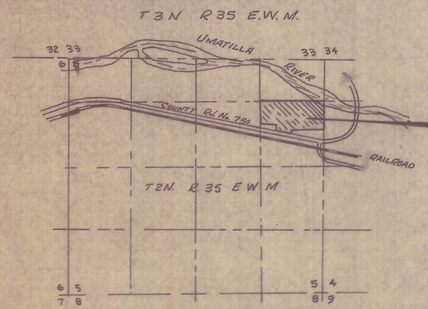

VICINITY MAP
1" = 2,000'

LEGAL DESCRIPTION OF THE WALTER LEWIS CLARK AND EILEEN MAE CLARK LAND
HUSBAND AND WIFE, THORNHOLLOW, UMATILLA COUNTY, STATE OF OREGON.

(A)

Beginning at the Southeast corner of the Northeast Quarter of Section 5, Township 2N, Range 35 East of the Willamette Meridian; thence North 03°22' East along the East line of said section a distance of 672.15 feet to Corner #1 a brass cap monument marking the Northeast Corner of the South half of the Southeast quarter of the Northeast Quarter of said section, said monument also being the true point of beginning for this description; thence continuing North 03°22' East along the West line of said section a distance of 670.95 feet to Corner #2 and the Northeast Corner of the Southeast Quarter of the Northeast Quarter of said section; thence South 89°30' West a distance of 1325.96 feet to a brass cap monument marking Corner #3 and the Northwest Corner of the Southeast Quarter of the Northeast Quarter of said section; thence South 03°22' West a distance of ~~485.60~~ 490.18 feet to Corner #4; thence South 85°56' East a distance of 209.18 ~~181.41~~ feet to Corner #5; thence South 85°55' 54" East a distance of 149.40 feet to Corner #6; thence South 02°48'28" West a distance of 246.50 feet to a point on the North Right-of-Way line of County Road No. 750 and Corner #7; thence South 75°53' East along said North Right-of-Way a distance of 323.2 feet to Corner #8; thence North 01°24' West a distance of 177.8 feet to Corner #9; thence North 89°44' East a distance of 678.00 feet to Corner #1 and the true point of beginning for this land survey description.

All being in the Southeast Quarter of the Northeast Quarter of Section 5, Township 2 North, Range 35 East of the Willamette Meridian, County of Umatilla and State of Oregon.

SURVEY CORRECTED 12-16-68

Fd. Brass Cap Mon.
1320±
Fd. Brass Cap Mon.
1/16 Corner
N 89° 30' W 1325.96
IDENTICAL
N 03°22'E 670.95'
S 03°22'W 681.62'

PARCEL IN THE S.E. 1/4, N.E. 1/4
SEC. 5, T. 2 N, R. 35 E. W.M.

WALTER & EILEEN CLARK
LAND
(A)

S 85°56'E 181.41'
S 85°55'54"E 149.40
N 03°22'E 672.15'
S 02°48'28"W 246.50
N 02°48'28"E 177.26'
N 75°53'W 178.26'
100.88
Fd. Brass Cap Monument
BY DEED S 75°53' E North R/W 323.3'
COUNTY ROAD NO. 750
682.5' BY DEED DESCRIPTION
FOUND TO BE AND SURVEYED AS N 89°44' E 678.0' West 678' BY DEED
FOUND TO BE AND SURVEYED AS N 01°24' E 177.80' SOUTH 177.8' BY DEED
Deed Recorded in Book 285 - Page 167
N 03°22' E 349' BY DEED
Section 5
Section 4
N 03°22' E 672.15' Bearing by Deed
Found 1/4 Corner Brass Cap Mon.
Found 1/4 Corner Brass Cap Mon.

C
13

LEGEND
FOUND MONUMENTS ▲
SET 1/2" x 30" IRON PIN ⊙

SCALE 1" = 100'

J. VAL TORONTO & ASSOCIATES
CONSULTING ENGINEERS
PENDLETON, OREGON

PROJECT: CLARK LAND SURVEY THORN HOLLOW
DETAIL DRAWING:
DATE: Oct.-21-1968 Corrected 12-16-68 SCALE: 1" = 100' SHEET 1
DELINEATOR: N.T. L.M. CKD:

REV. 12-16-68

REGISTERED PROFESSIONAL ENGINEER 5502 OREGON JAN. 6, 1967 JOHN VAL TORONTO

F-4