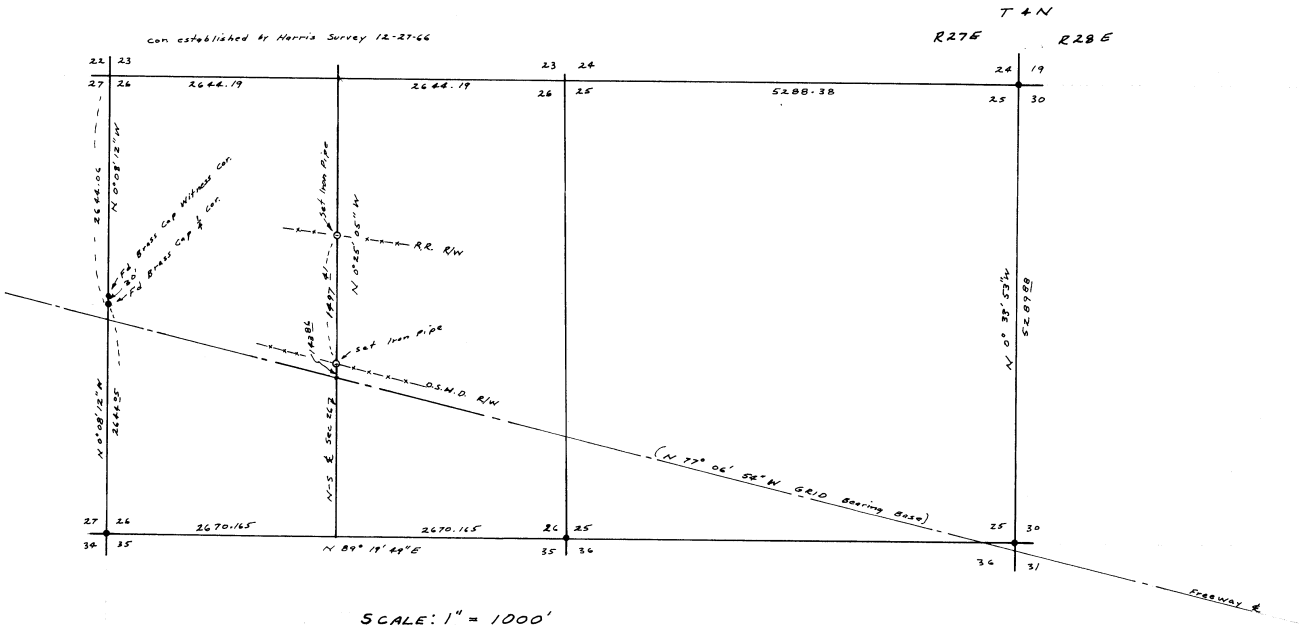

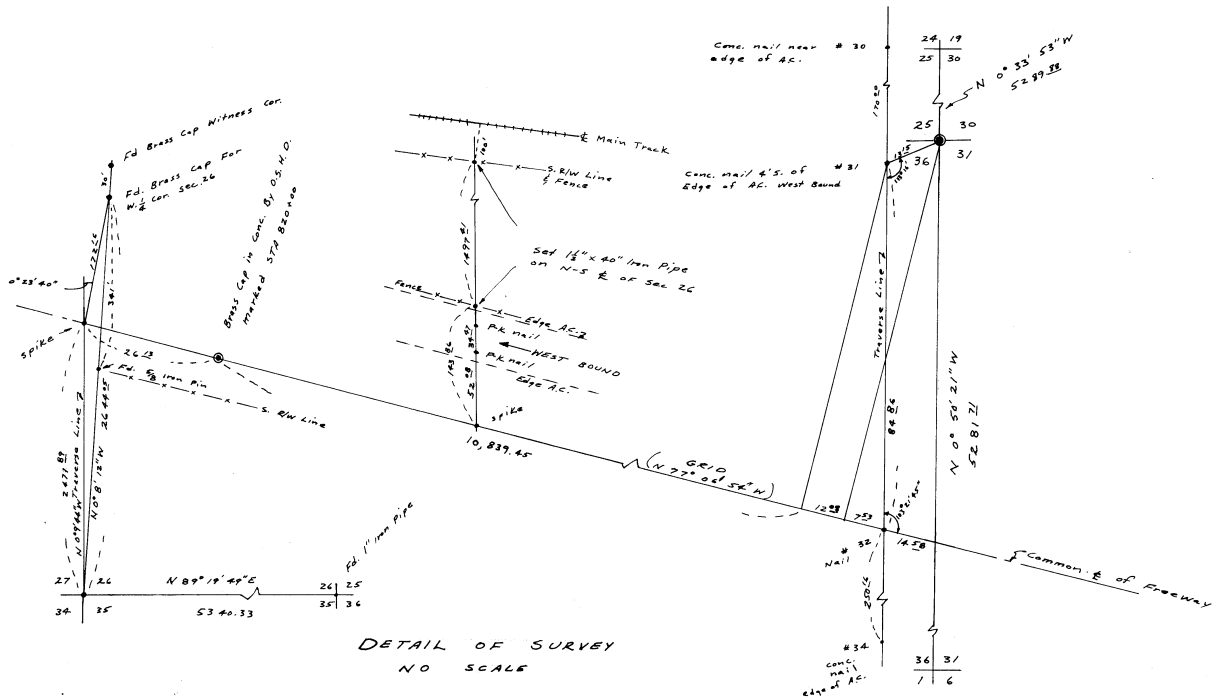

DETAIL OF SURVEY
NO SCALE

REGISTERED PROFESSIONAL ENGINEER 5408 OREGON JULY 9 1965 DONALD L. STAEBLER

SURVEY TO SET NORTH-SOUTH CENTERLINE OF SECTION 26 T 4 N, R 27 E.W.M BETWEEN THE HIGHWAY & RAILROAD FOR LYLE SMITH OF LONGVIEW, WA.

8-24-71 | SCALE: AS SHOWN

DONALD L. STAEBLER
CONSULTING ENGINEER
P.O. BOX 91
PENDLETON OREGON

H-119-B