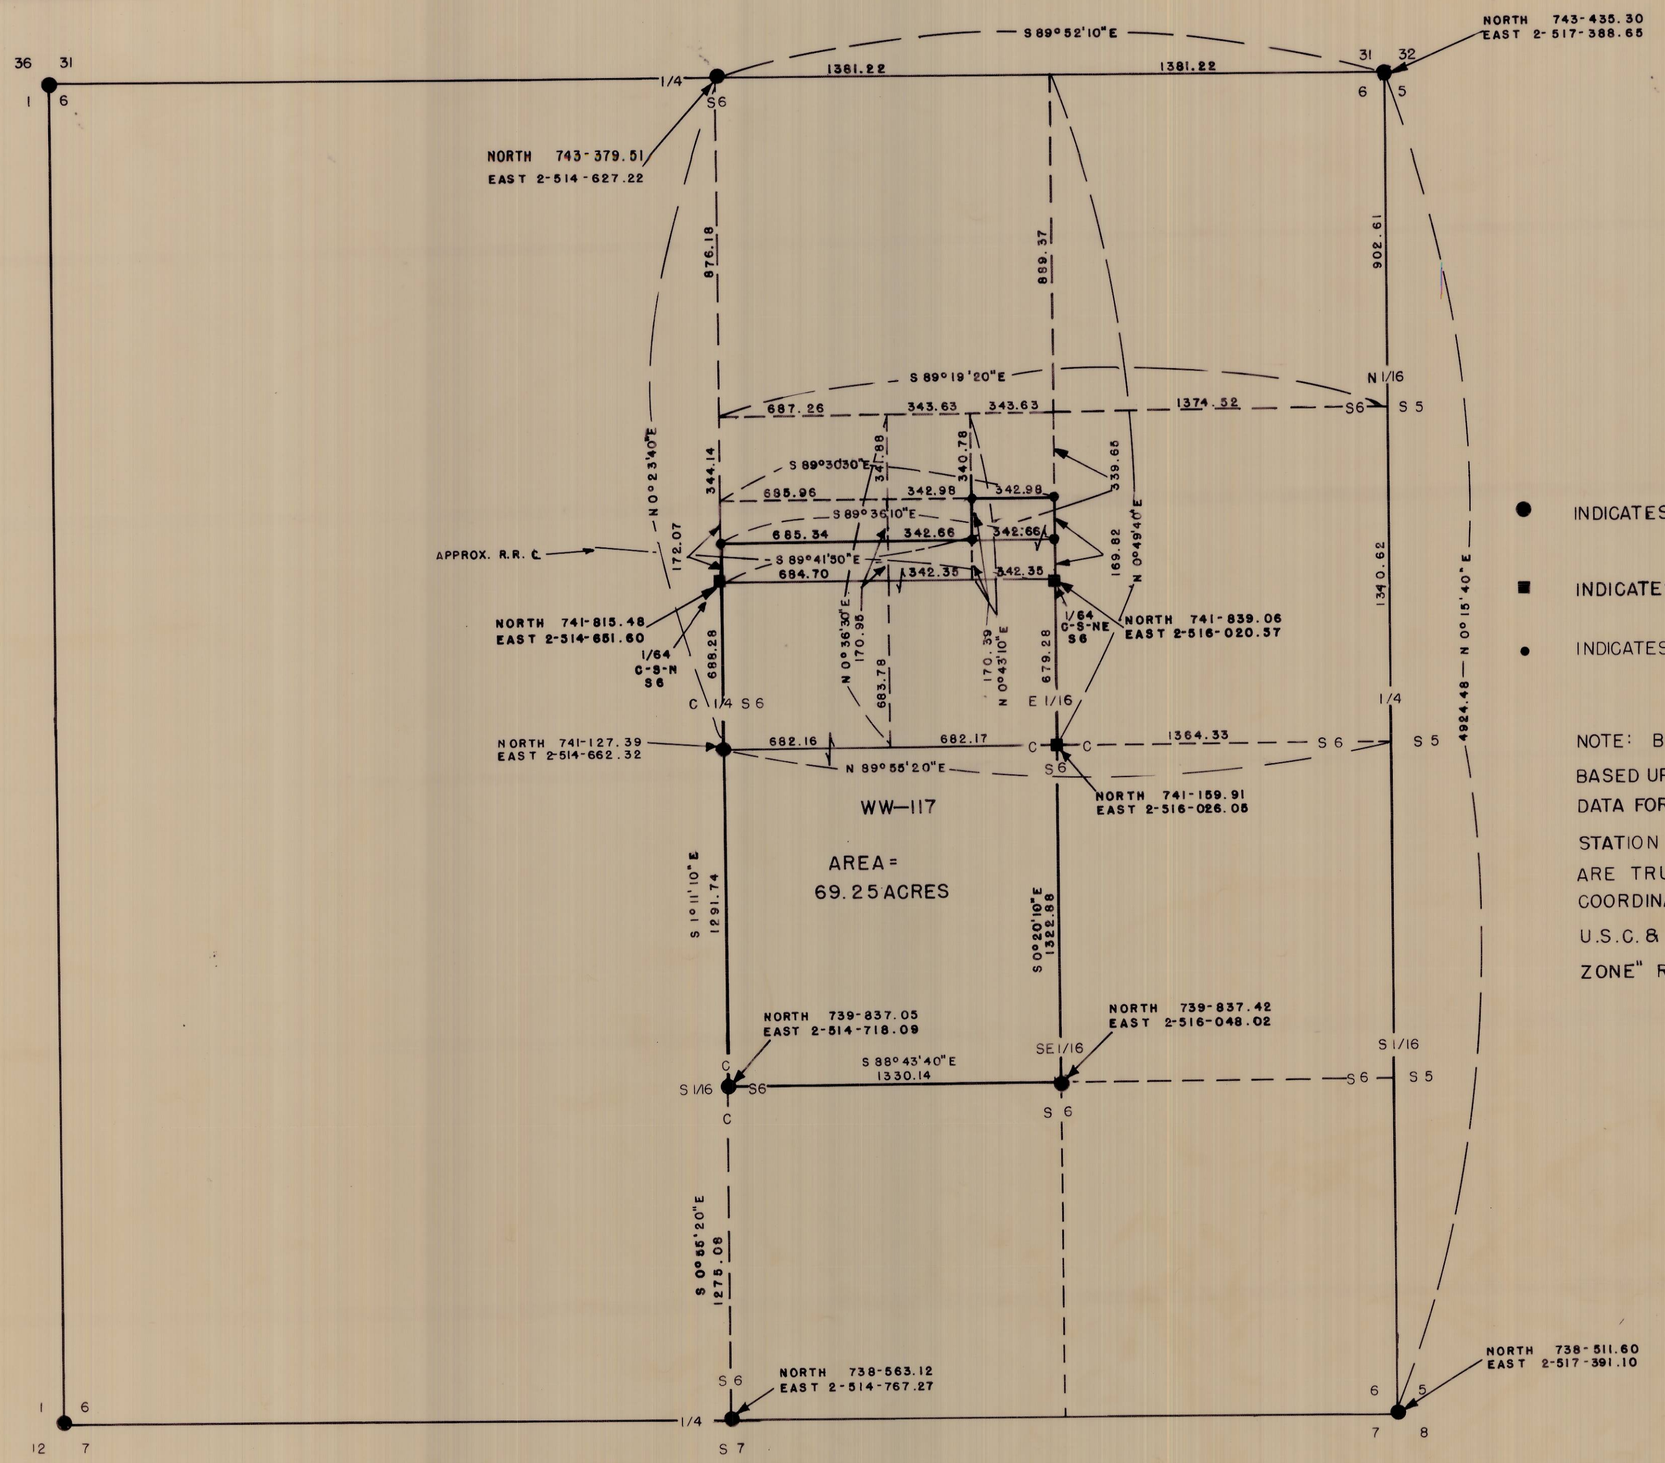

● INDICATES 1 1/2" I. PIPE W/BRASS CAP FOUND

■ INDICATES 1 1/2" I. PIPE W/BRASS CAP SET

• INDICATES 5/8" I. PIN SET

NOTE: BEARINGS ARE BASED UPON PRELIMINARY DATA FOR U.S.C. & G.S. STATION "HOMLY" THEY ARE TRUE BEARINGS. COORDINATES SHOWN ARE U.S.C. & G.S. "OREGON NORTH ZONE" REDUCED TO SEA LEVEL.

REGISTERED
OREGON
LAND SURVEYOR
David H. Krumbein
JULY 17, 1970
DAVID H. KRUMBEIN
933

WAYNE HARRIS COMPANY, INC.

SURVEY FOR

BUREAU OF INDIAN AFFAIRS

W.W.117, SEC. 6, T. 2 N, R. 35, E.W.M.

SCALE	DATE	DRWN. BY	DRNG. NO.
1"= 400'	4-6-71	DNS	71-271-C

H 223-B