


H-255-B

10000E
10000E
10000E
10000E

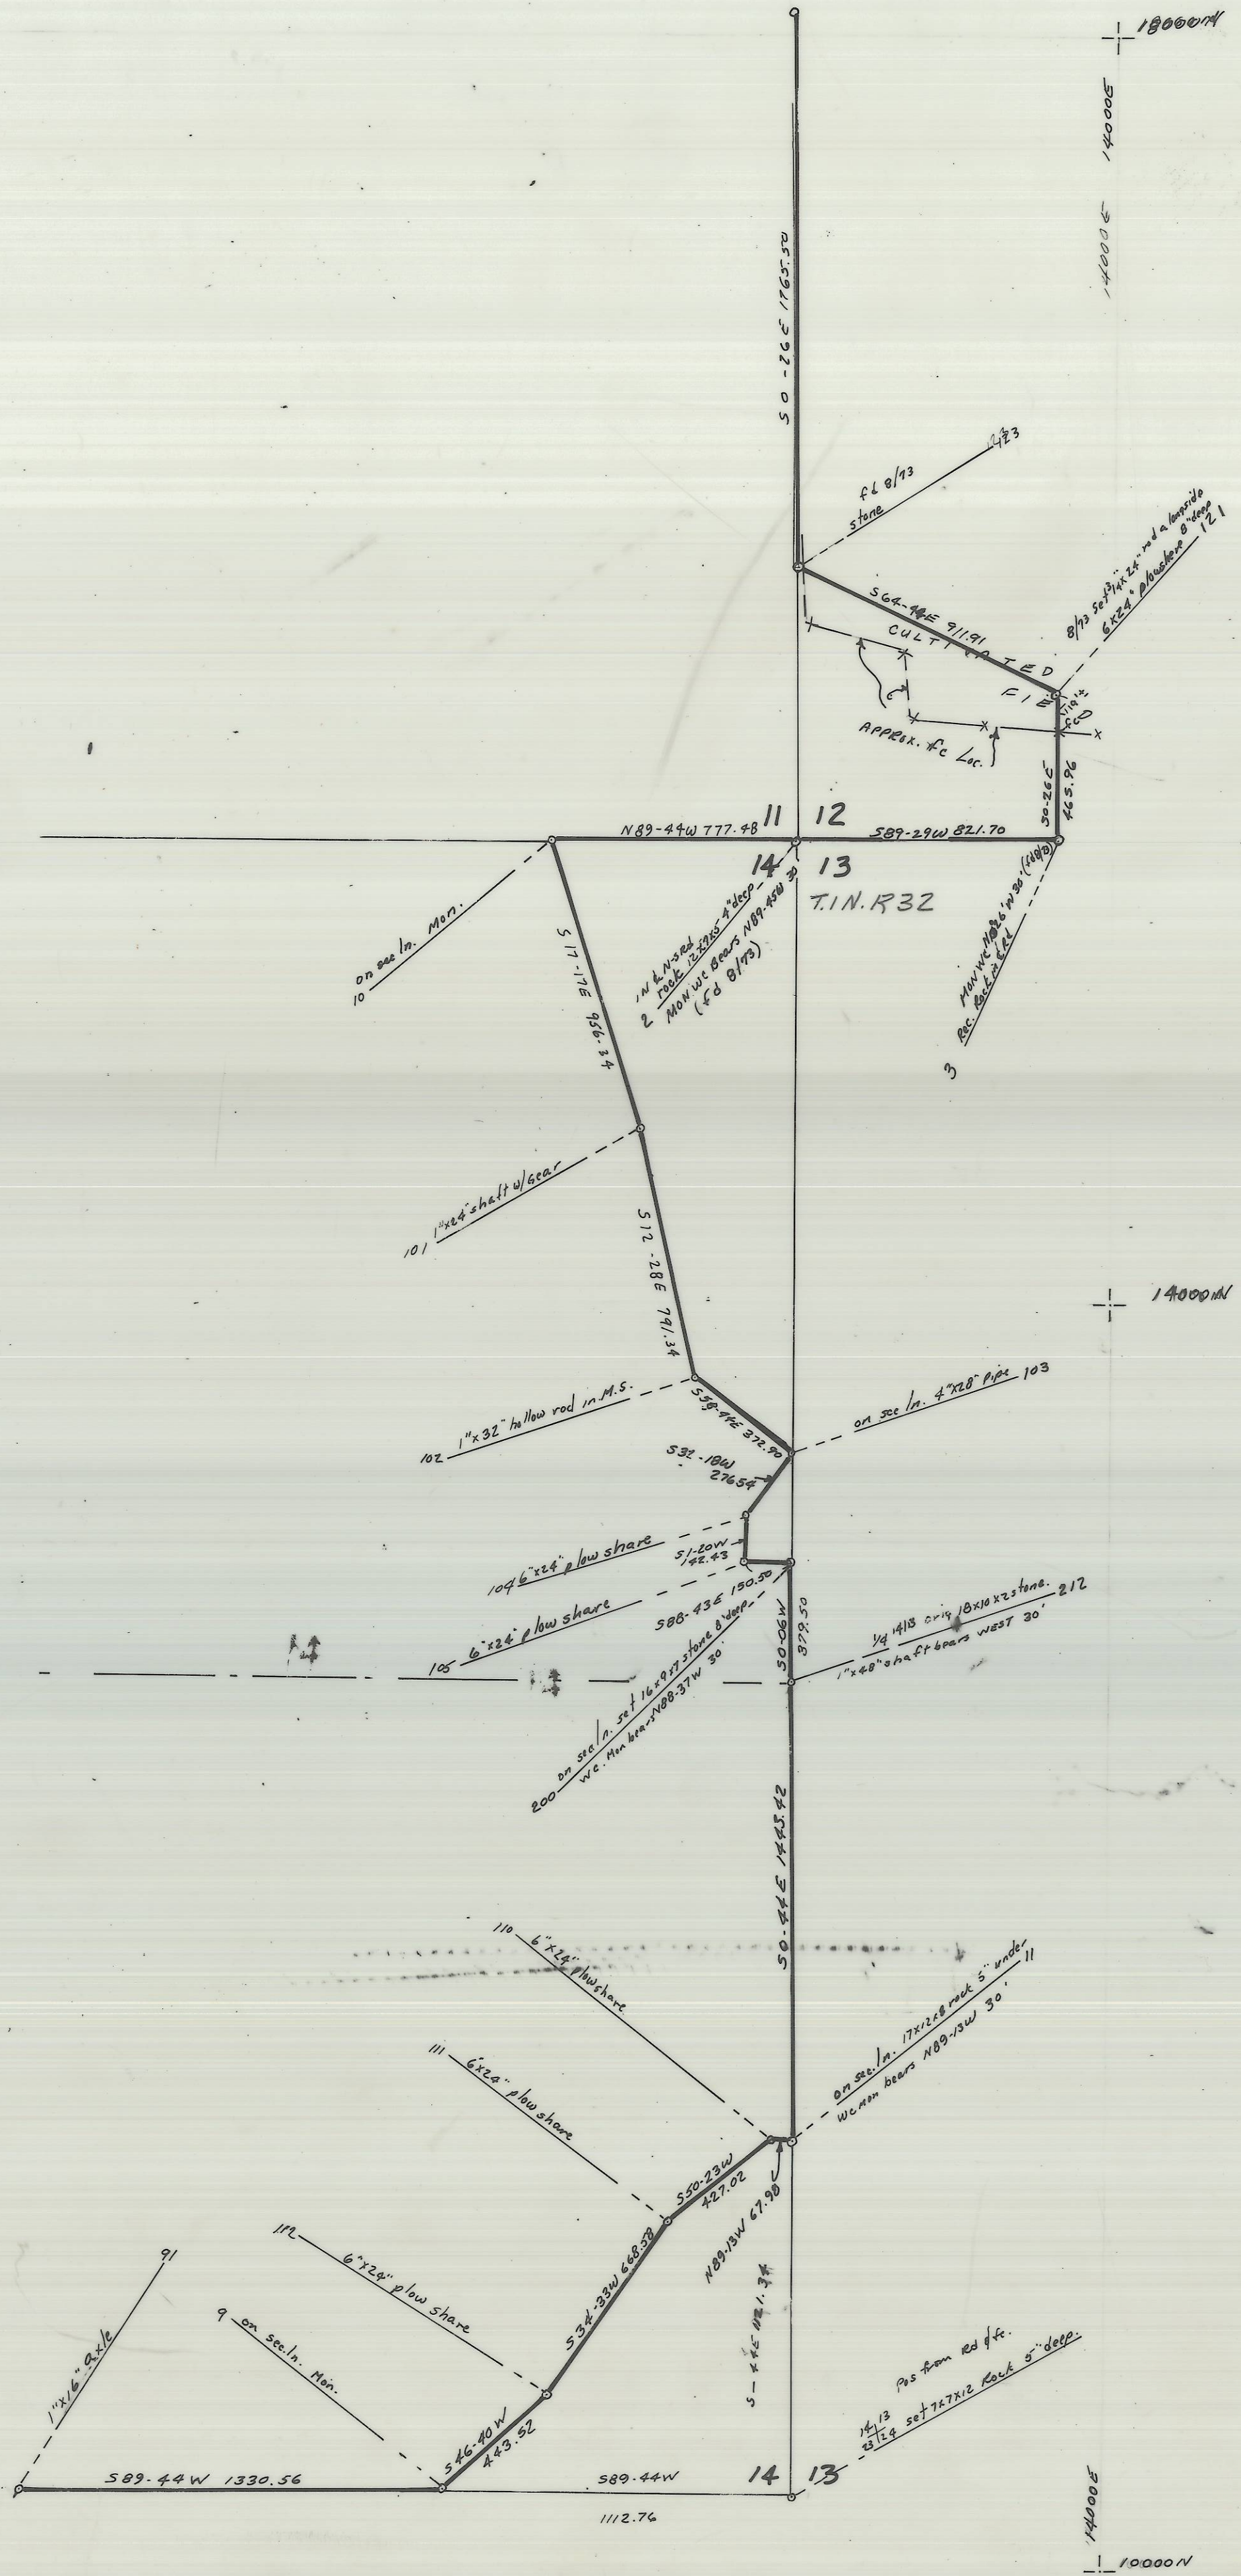

3A

OREGON
 MCKAY CREEK NWR
 SCALE 1"=400'
 Surveyed 1938
 H-255
 H-255

10000E
14000N