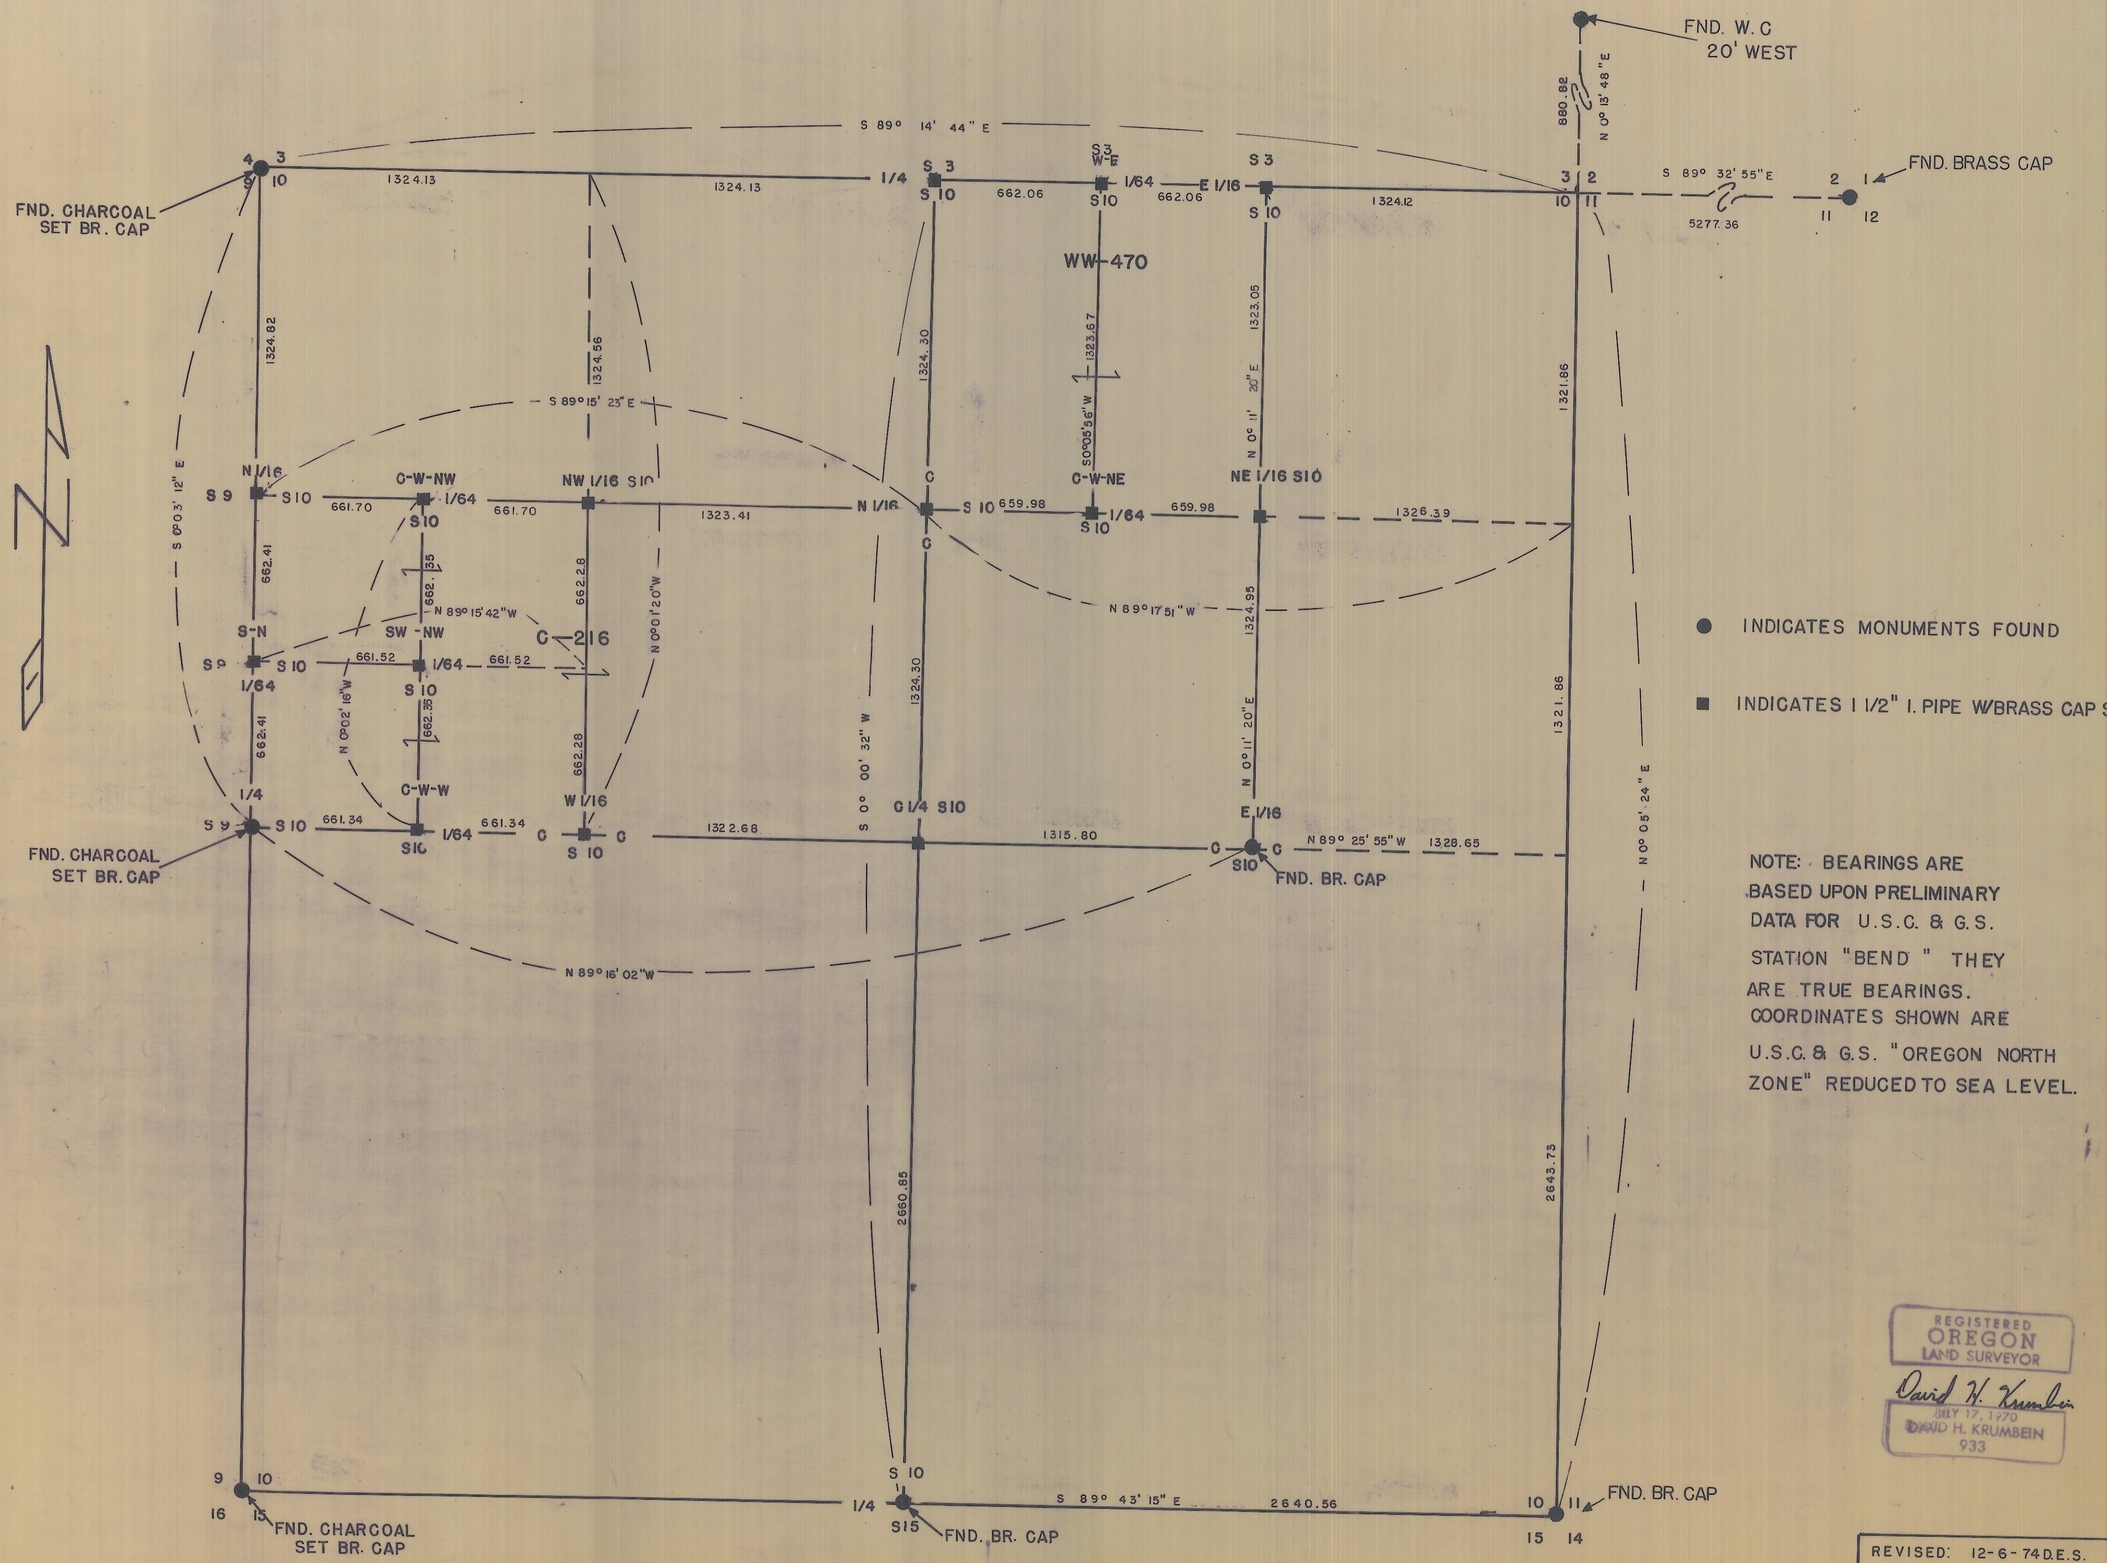

● INDICATES MONUMENTS FOUND

■ INDICATES 1 1/2" I. PIPE W/BRASS CAP SET

NOTE: BEARINGS ARE BASED UPON PRELIMINARY DATA FOR U.S.C. & G.S. STATION "BEND" THEY ARE TRUE BEARINGS. COORDINATES SHOWN ARE U.S.C. & G.S. "OREGON NORTH ZONE" REDUCED TO SEA LEVEL.

REGISTERED
OREGON
LAND SURVEYOR
David H. Krumbein
JULY 17, 1970
DAVID H. KRUMBEIN
933

REVISED: 12-6-74 D.E.S.

WAYNE HARRIS COMPANY, INC.

SURVEY FOR I-164-B

BUREAU OF INDIAN AFFAIRS

ALLOTMENT NOS. C-216; WW-470
Sec. 10, T. 1N., R. 33E., W.M.

SCALE	DATE	DRWN. BY	DRNG. NO.
1" = 400'	5-7-71	DNS	71-273-C