


CHARLES F. GRIGG
 4.57 ACRES
 LOCATED IN THE SW 1/4 OF THE SW 1/4
 SEC. 2, T4N, R28E, W.M.
 UMATILLA COUNTY, OREGON

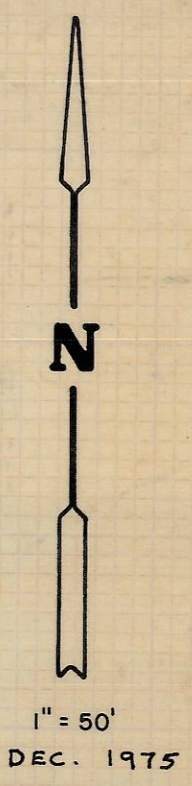

NOTE: GRID BEARINGS.
 TRUE DISTANCES.
 BASE BEARING IS HERM. BUTTE TO
 HERM. AIR S 56° 58' 39\"/>

- SET 5/8" x 30" L. PIN



NORPA DEVELOPMENT, INC.
 240 E. GLADYS AVE.
 HERMISTON, ORE. 97838

DONALD L. STAEBLER
 REGISTERED PROFESSIONAL ENGINEER
 NO. 5408

K-6-B

75-019