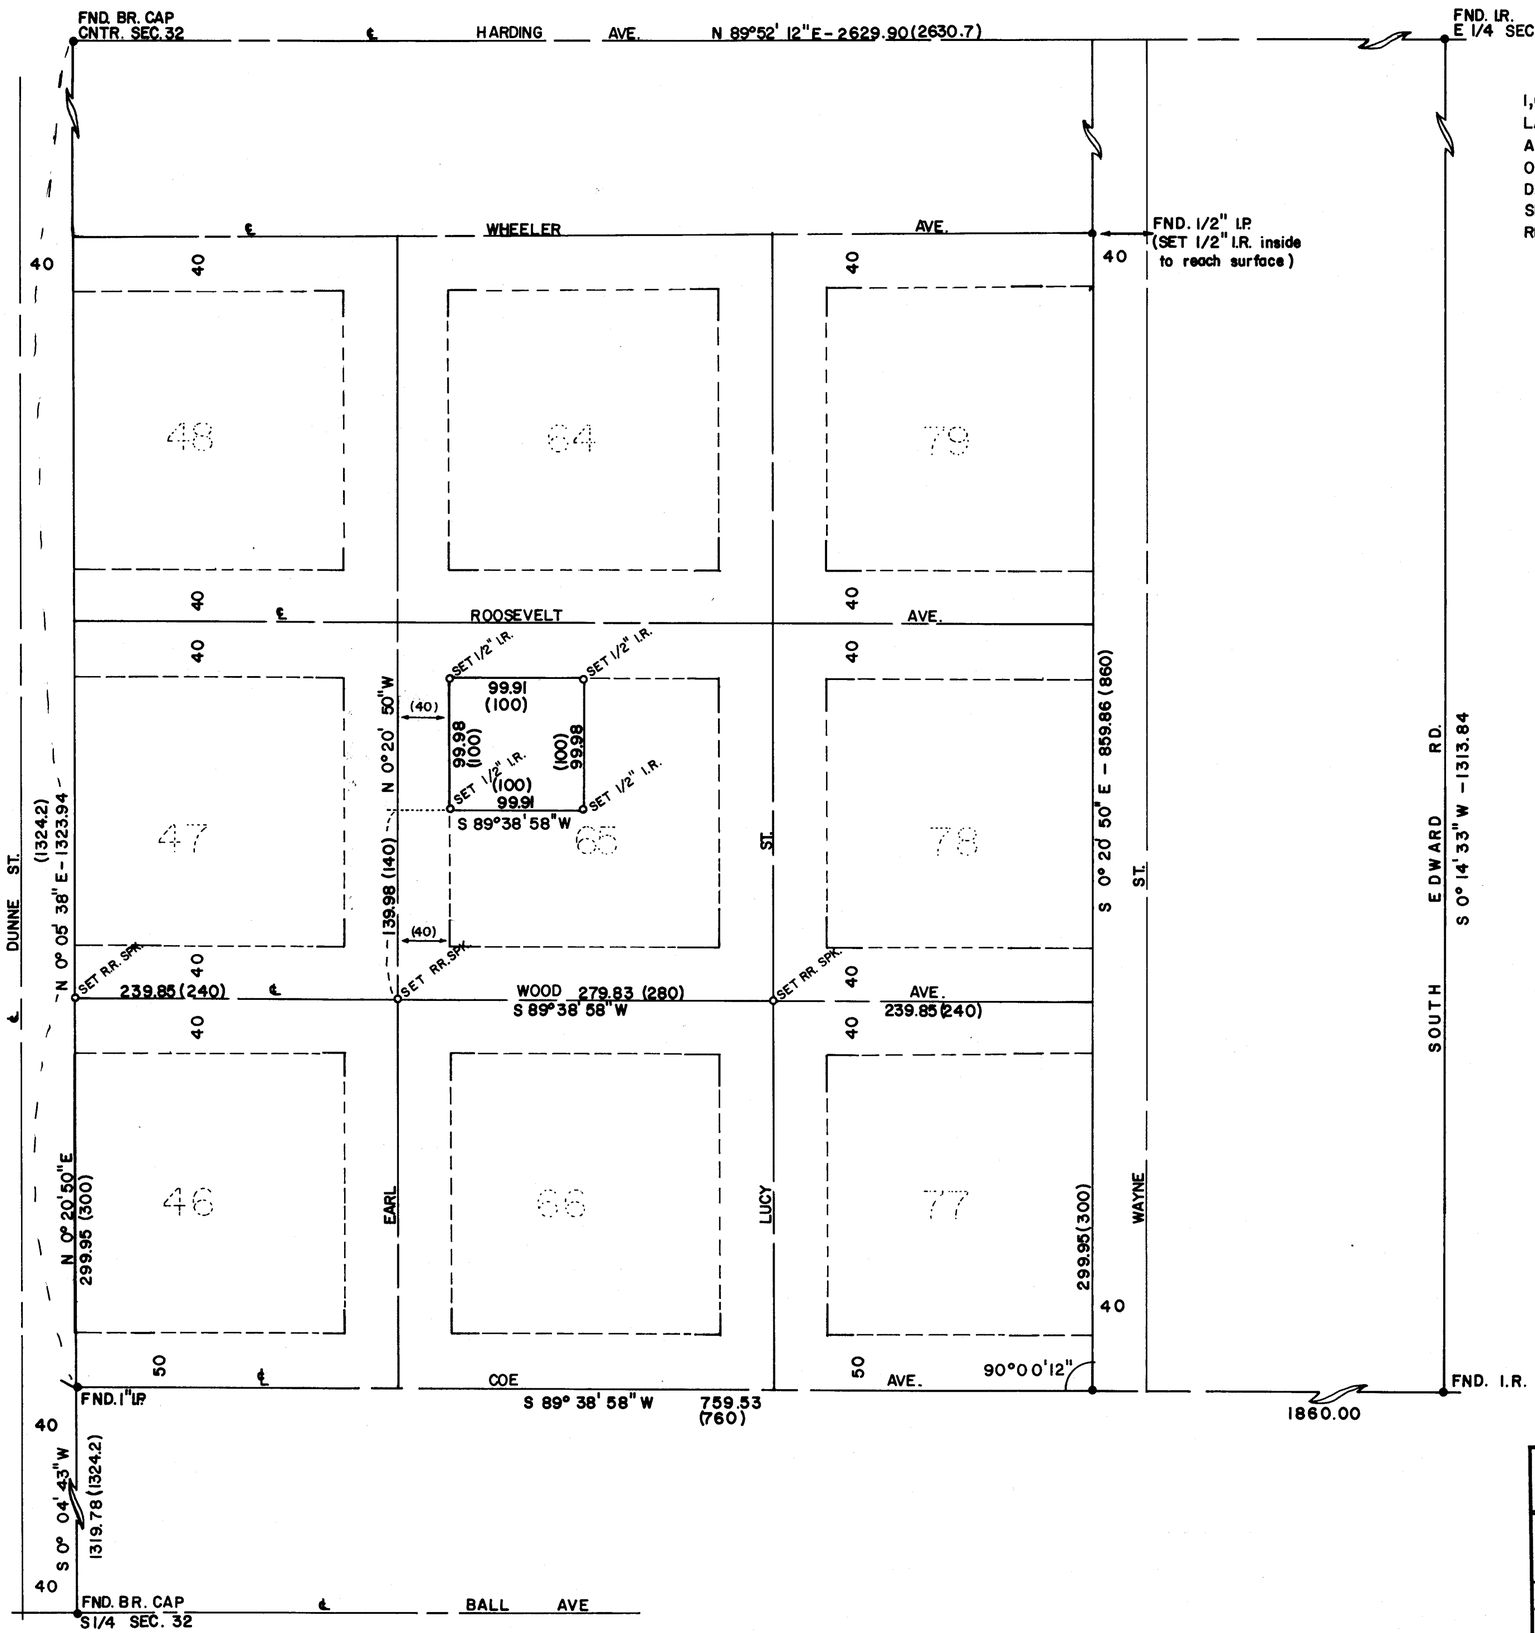

CERTIFICATION

I, G. DENNIS EDWARDS A REGISTERED PROFESSIONAL LAND SURVEYOR HEREBY CERTIFY THAT ON 2/2/76 A SURVEY WAS STARTED AND COMPLETED ON 2/13/76 OF THE LAND SHOWN HEREON BY ME OR UNDER MY DIRECTION THAT THE PROPERTY CORNERS ARE MARKED AS SHOWN, AND THAT THIS MAP IS A TRUE AND ACCURATE REPRESENTATION OF SAID SURVEY.

REGISTERED PROFESSIONAL LAND SURVEYOR

G. Dennis Edwards

OREGON JULY 16, 1971 G. DENNIS EDWARDS 951

SCALE 1" = 80'
BASIS OF BRNGS., POLARIS OBSERVATION 2/5/76

K-043-B

LOTS 13-16, BLOCK 65, COE'S FIRST ADDITION TO THE CITY OF STANFIELD, NE 1/4, SEC 32, T4N, R 29E, W.M. UMATILLA COUNTY, OREGON

SURVEY FOR JOHN HUDSON

GASCHLER & ASSOCIATES
ONTARIO, OREGON HERMISTON, OREGON

DESIGNED BY:	DRAWN BY:	APPROVED BY:
DATE: 2/16/76	DRAWING NO. B-22	BK____ PG____
SHEET 1 OF 1	JOB NO. HSO-0776	REVISED:

IDAHO BLUEPRINT & SUPPLY CO., INC., BOISE, IDAHO