


Scale 1" = 50'

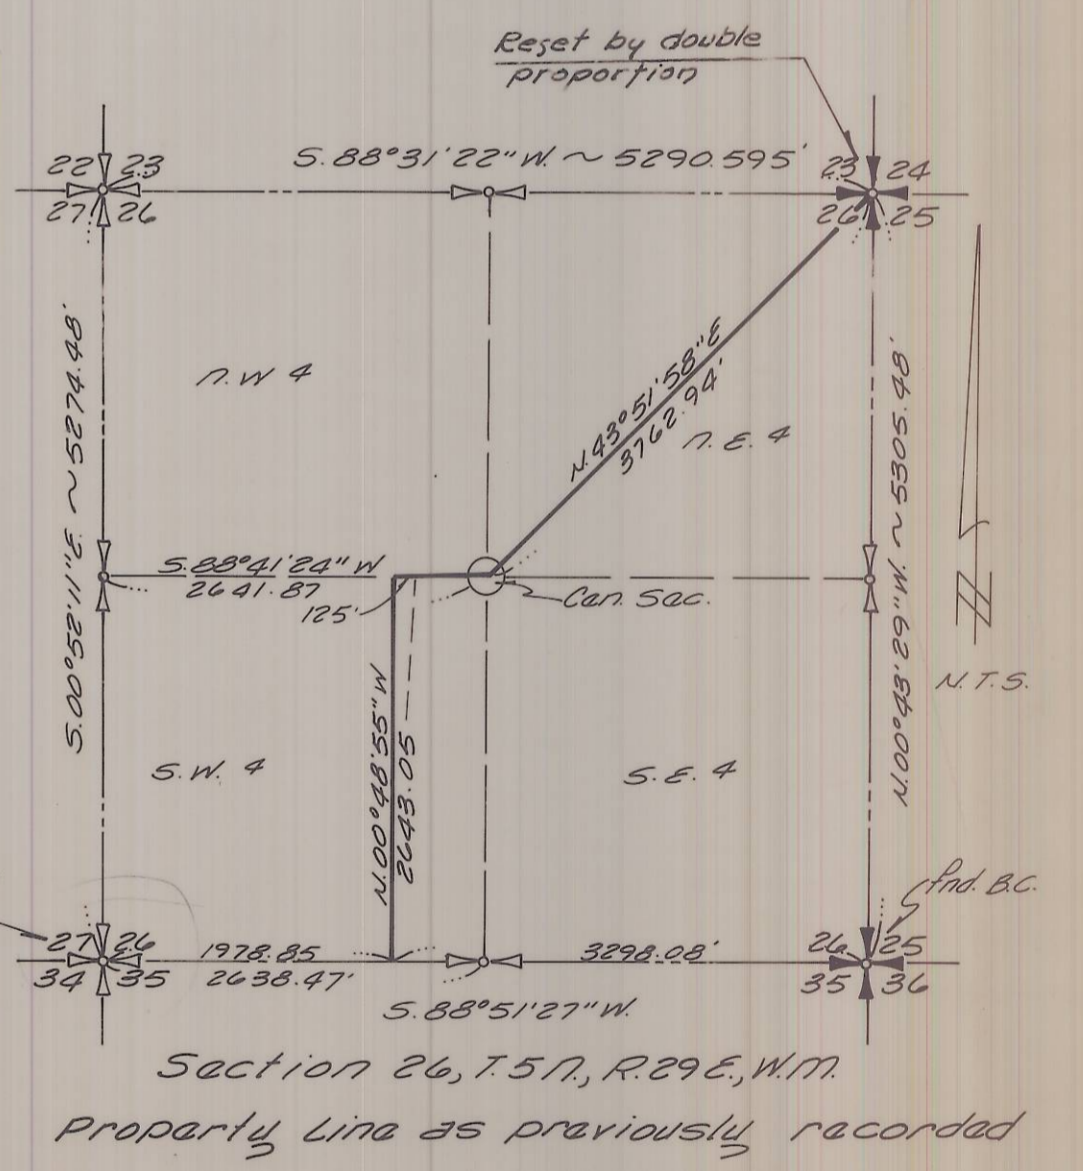

LEGEND

- x — x — x — Indicates new prop line w/ fence
- — — — — Indicates old prop line
- Denotes new prop cor.
- Denotes Prop cor. of record

Basis of Bearing Oregon North Zone, Lambert Grid

REGISTERED PROFESSIONAL LAND SURVEYOR
Richard A. Rogers 5/6/77
 RICHARD A. ROGERS

M-87

ROGERS SURVEYING INC. P.S.		CLIENT Dr. R.W. Bradshaw	
PROFESSIONAL LAND SURVEYORS		PROJECT LEGAL SURVEY	
P.O. Box 507 Richland, Washington Phone (509) 943-3151		DRN. BY <i>J.E.</i>	SCALE 1" = 50'
APPROVED	DATE 4-18-77	JOB 25576	SHEET 1 OF 1

M-87-B