RECORD OF SURVEY
FOR
UMATILLA ELECTRIC COOPERATIVE
OF A TRACT OF A LAND IN SECTION 3, T4N, R28E. W.M. UMATILLA COUNTY, OREGON

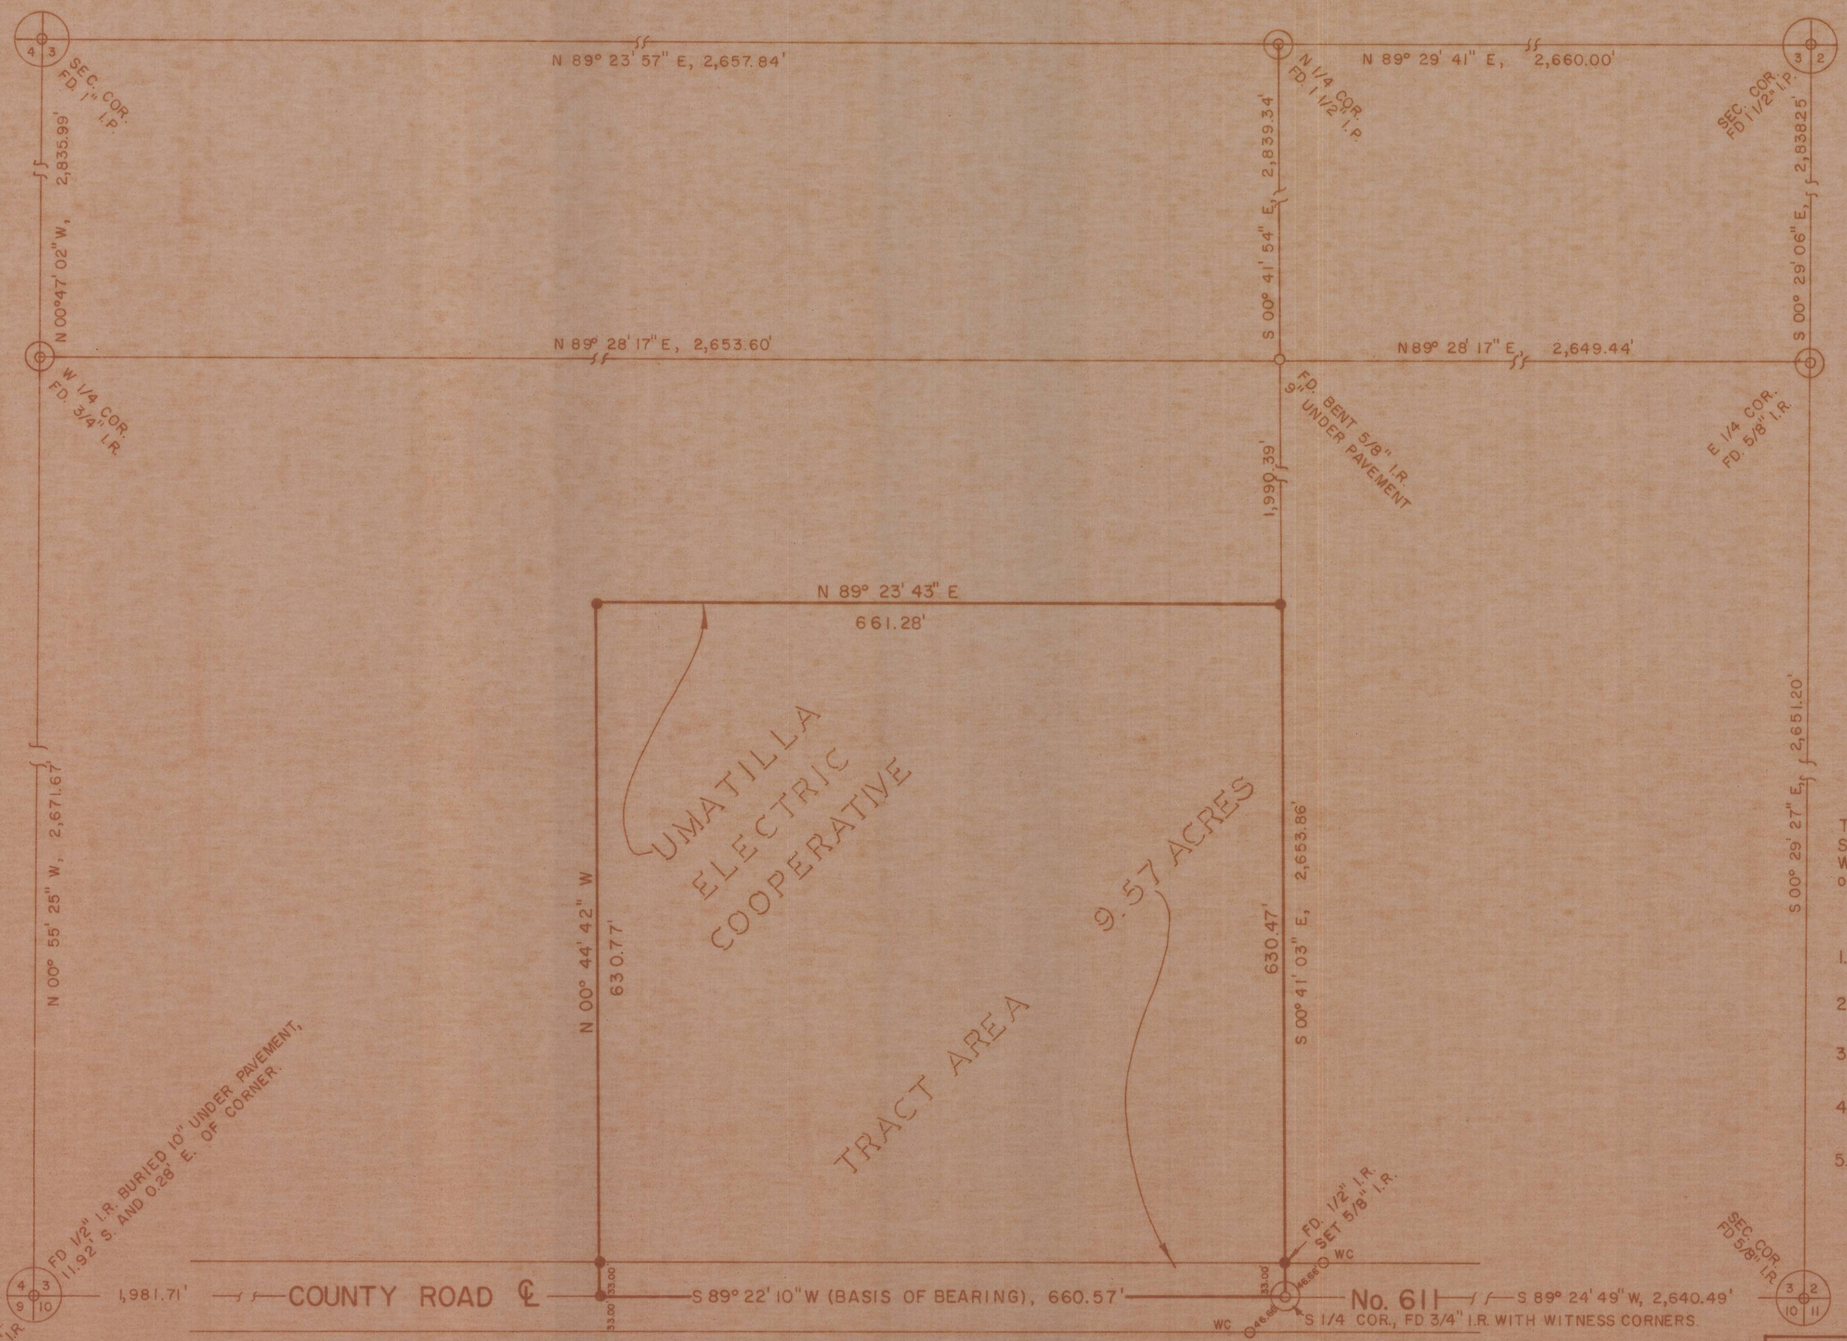

LEGEND

- ○ Found monuments as noted.
- ● Set 5/8" X 30" iron rods.

DESCRIPTION OF TRACT

The SE1/4 of the SE1/4 of the SW1/4 of Section 3, T4N R28E. W.M. Excepting all Water Rights of Way and Roads.

REFERENCES

1. Record of survey by Ambrose Shea, of 12/21/72.
2. Record of survey by Donald Staebler, of 12/75.
3. Record of survey by Wayne Harris, of 1/26/76.
4. Original Township survey by Ebenezer Haft, Sept. 11, 1860.
5. Deed to Umatilla Electric Coop., Recorded Deed Book 227, pg. 133, July 29, 1955.

REGISTERED PROFESSIONAL LAND SURVEYOR OREGON JULY 9, 1974 HOMER F. TELEK

RECORD OF SURVEY	
DATE NOV. 1976	TELEK ENGINEERING 540 SW 11th HERMISTON, OREGON

M-110-B