
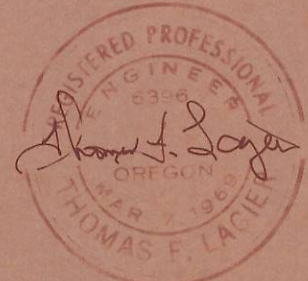


RECORD OF SURVEY FOR UMATILLA ELECTRIC COOPERATIVE
 OF A TRACT OF LAND IN
 SECTION 9, T 2 N, R 33 E, W.M.
 UMATILLA COUNTY, OREGON

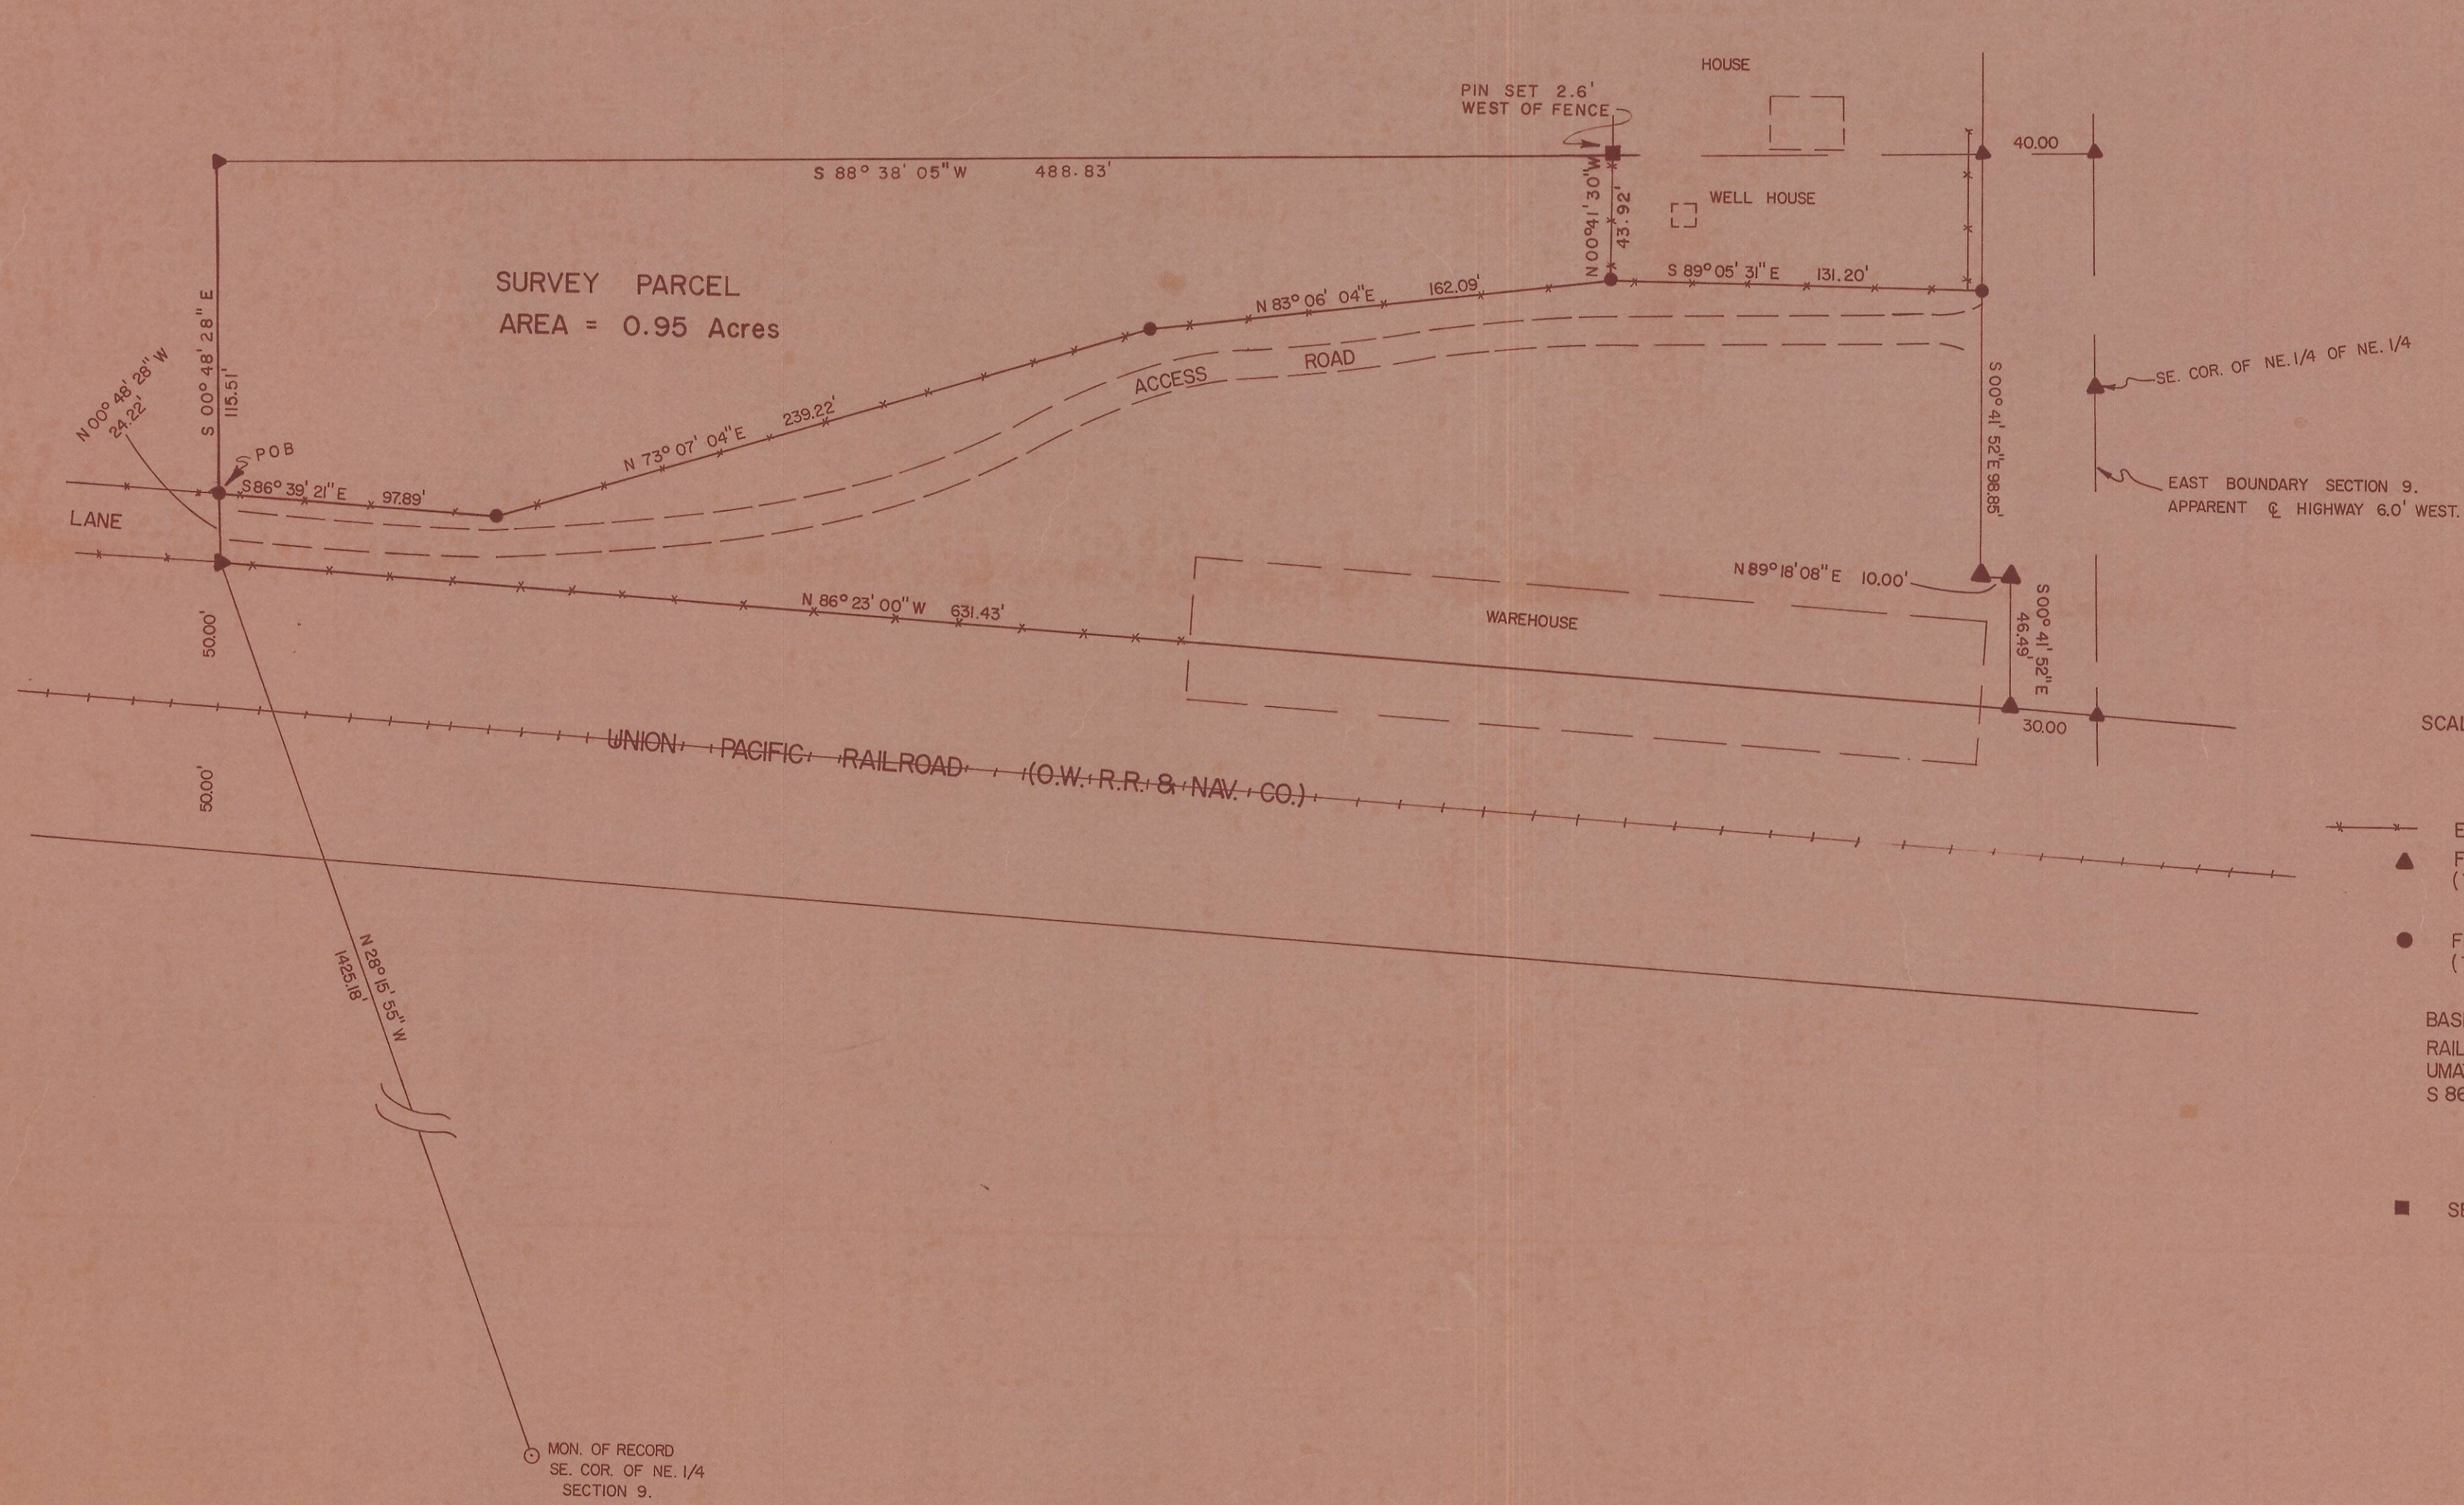

RECORD OF SURVEY	
JUNE 1977	TELEK ENGINEERING 540 SW. 11th HERMISTON, OREGON 97838

N-66-B