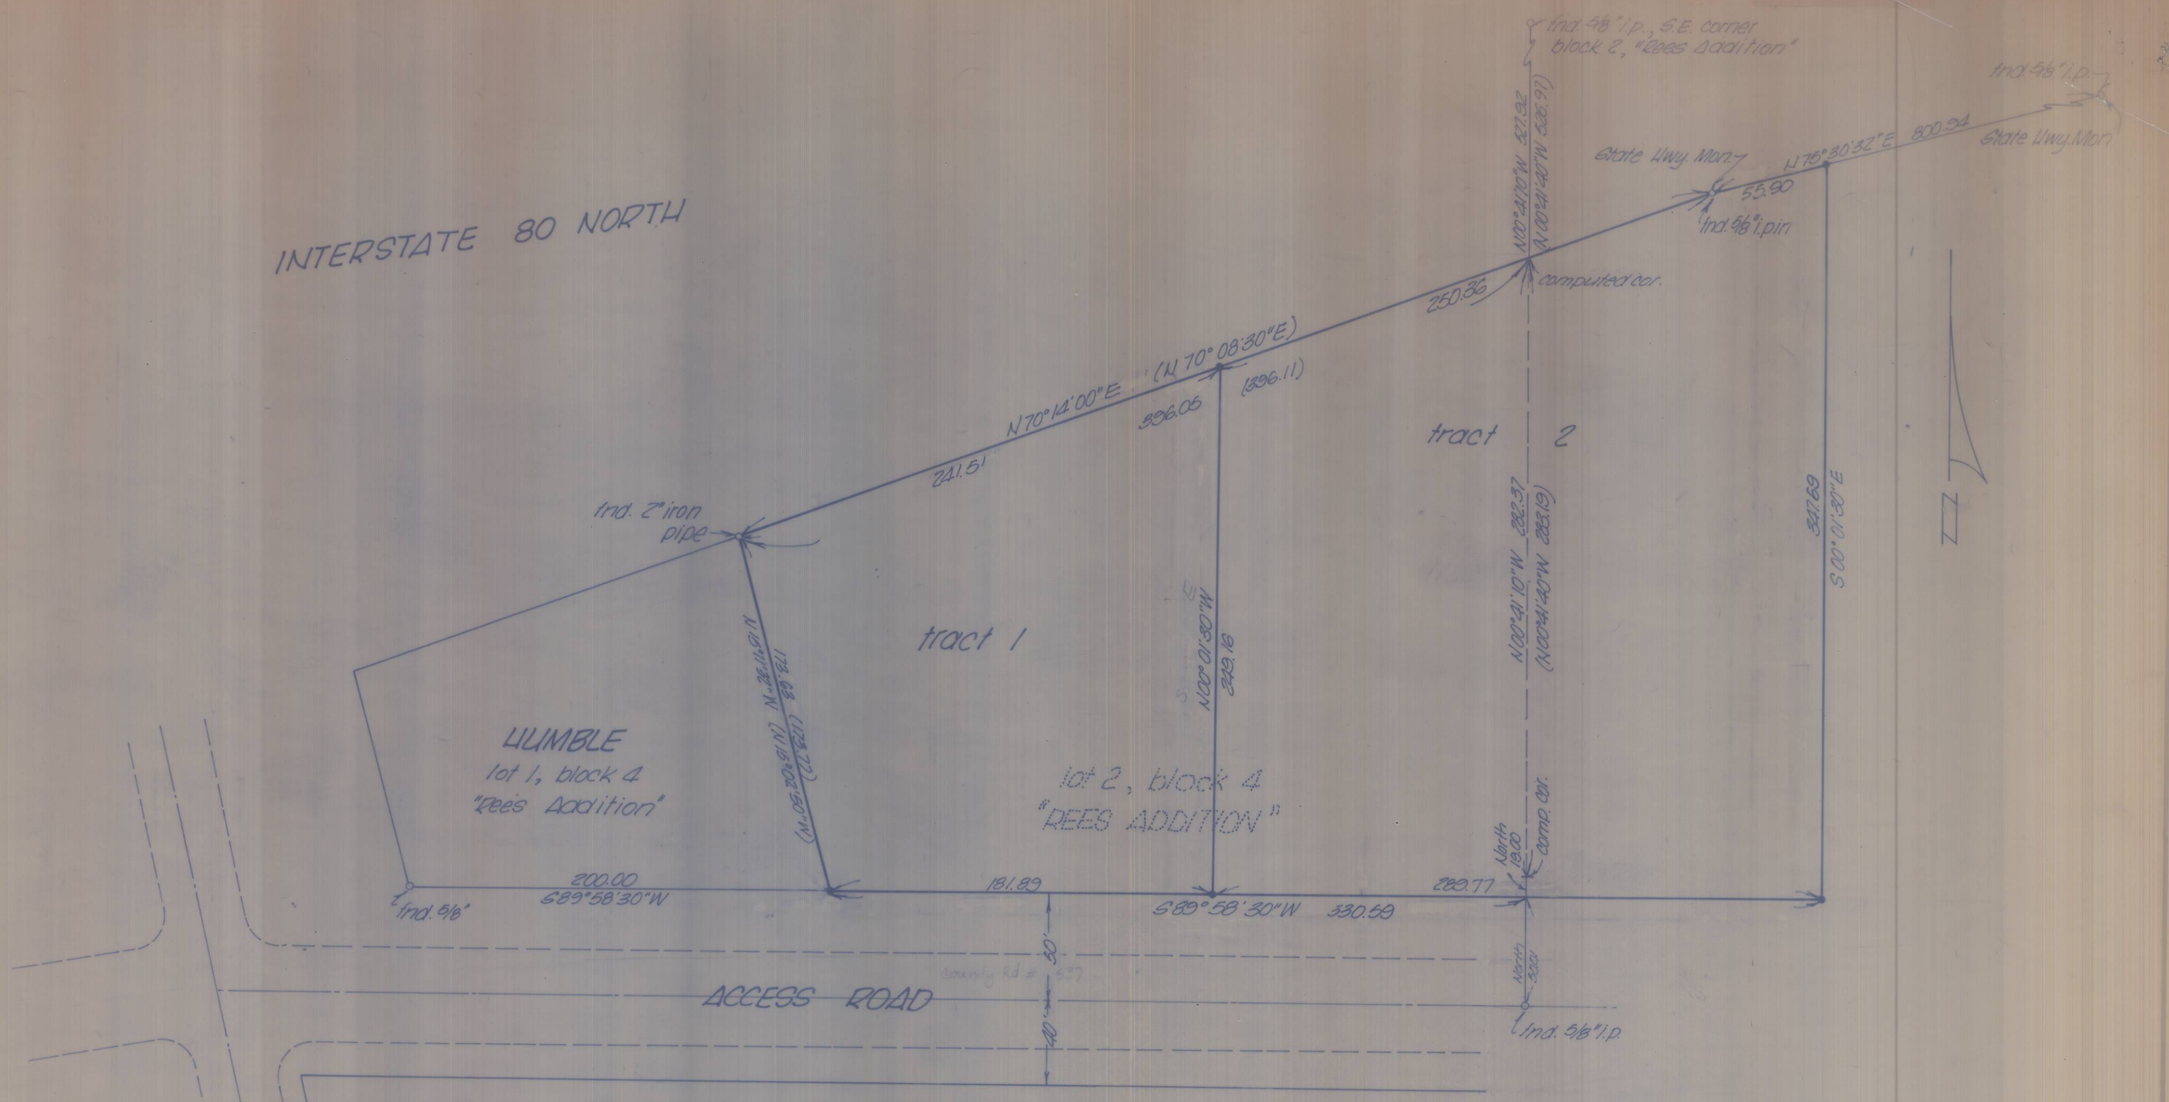

• - denotes 5/8" i.pin set
( ) - denotes platted info.

Note:
Bearings are based on the original Plat of "Rees Addition" dated September, 1969.

Revised May 21, 1978 - D.L.S.
Revised March 30, 1978 - D.L.S.
Revised July 27, 1977 - D.L.S.

REGISTERED PROFESSIONAL LAND SURVEYOR
James H. Buchanan
OREGON
MAY 26, 1967
JAMES H. BUCHANAN
1367

KRUMBEIN ENGINEERING CO.
ENGINEERS – SURVEYORS – PLANNERS
221 S. Main, Pendleton, Oregon

Survey for
11-80 CORPORATION
S.W. 1/4, Sec. 11, T.3N., R.35E.

SCALE: 1" = 100'
DATE: June 9, 1977
DRN. BY: D.L.S.
CKD. BY: J.H.B.
DRWG. NO.: 77-6-22

N-75B