

NOTES:

Bearings based on observation of Polaris June 19, 1978. See Book 2, Page 146. Solar shots were taken for bearing check for Dead Tie Traverse. See traverse detail, Sheet 3 of 3. All bearings and distances shown are true.

All field notes on traverses for Section 11 are in Book 1. Notes used to set brass caps are in Book 2, pages 147-165. Accessory ties for all corners set in Section 11 are described in Certified Record of Land Monumentation.

Computation for all corners set based on Manual of Surveying Instruction 1973, Chapter 5. See Book 1, page 187.


LEGAL DESCRIPTION:

U.S. Forest Service ownership; all Section 11, excepting the Northeast one-quarter of the Northeast one-quarter of Section 11. All being in Township 5 South, Range 33 1/2 East of the Willamette Meridian.

I, David H. Krumbein, a registered land surveyor (Engineer) in the State of Oregon, hereby certify that this plat and the notes hereon, or attached, are a correct representation of a survey I performed during May-August 1978, for the U.S. Forest Service in accordance with the statutes of the State of Oregon and with the Articles of my contract.

David H. Krumbein (s) David H. Krumbein
Registered Land Surveyor
Oregon License No. 933

----- denotes U.S. Forest Service Boundary
● denotes Brass Cap
() denotes G.L.O. record bearings & distances

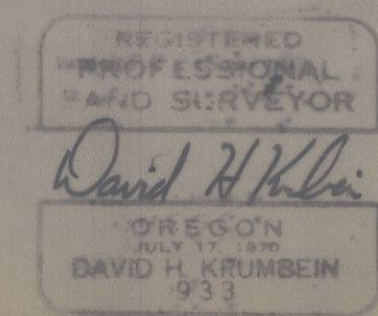

Sheet 2 of 3

K KRUMBEIN ENGINEERING CO. ENGINEERS - SURVEYORS - PLANNERS 221 S. Main, Pendleton, Oregon	SCALE 1" = 500'
	DATE Aug 3, 1978
Survey for U.S. FOREST SERVICE Section 11, T5S, R33 1/2 E, W.M.	DRN BY TAG
	CKD BY TEH
	DRNG NO. 78-560