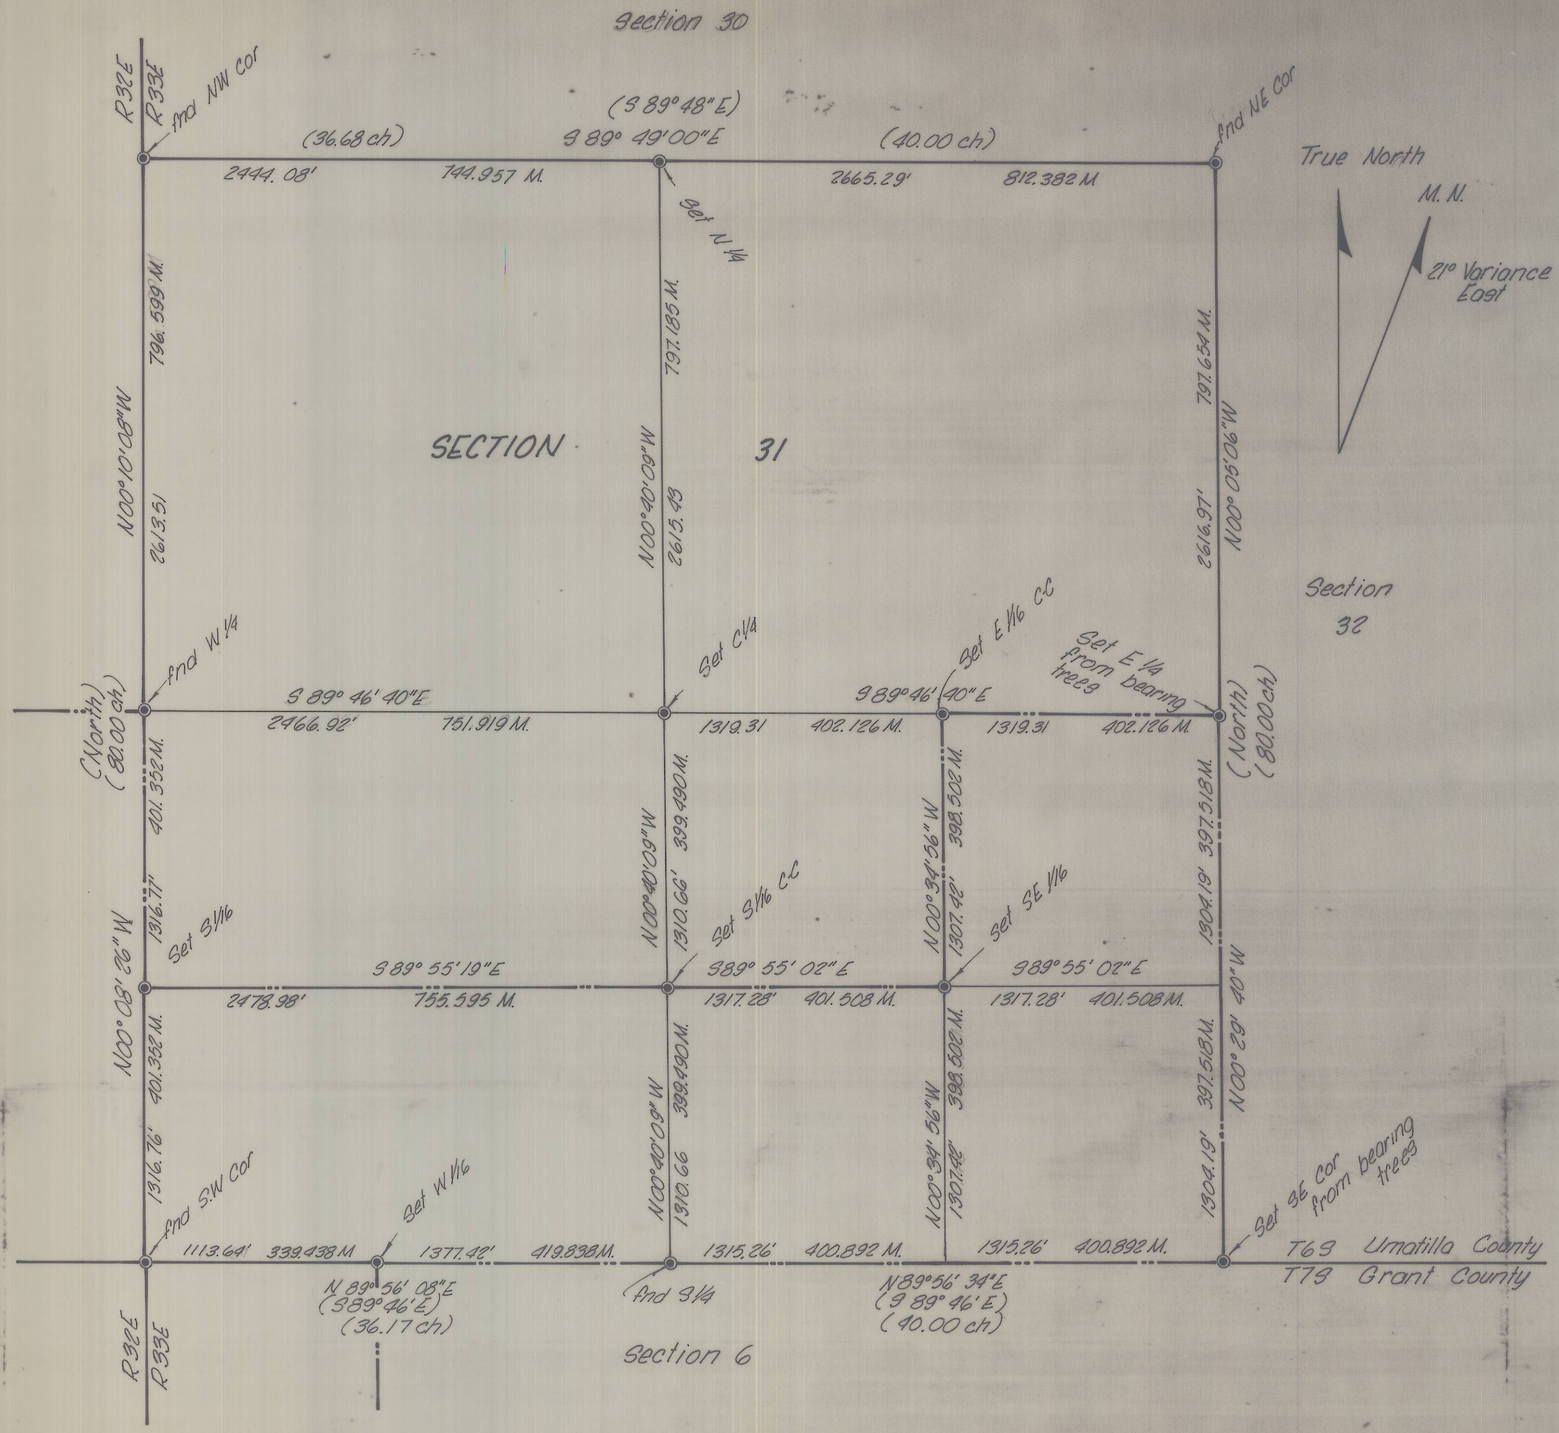

NOTES:

Bearings are based on observation of Polaris, August 3, 1978, SEE Book 1, pages 164-178, SEE Traverse Detail Sheet 3 of 3. All bearings and distances shown are true.

All field notes for traverses for Section 31 are in Book 1. Notes used to set Brass Caps are in Book 1, pages 180-198. All accessory ties for corners set in Section 31 are described in Certified Record of Land Monumentation.

Computations for all corners set are based on Manual of Surveying Instruction 1973, Chapter 5, see Book 1, page 199 for computation done.

LEGAL DESCRIPTION

U.S. Forest Service ownership; the South half of the Southwest one-quarter and all the Southeast one-quarter excepting the Northeast one-quarter of the Southeast one-quarter of Section 31, All being in Township 6 South, Range 33 East of the Willamette Meridian.

I, David H. Krumbein, a registered land surveyor (Engineer) in the State of Oregon, hereby certify that this plat and the notes hereon, or attached, are a correct representation of a survey I performed during May-August, 1978, for the U.S. Forest Service in accordance with the statutes of the State of Oregon and with the Articles of my contract.

David H Krumbein (3) David H. Krumbein
Registered Land Surveyor
Oregon License No. 933

REGISTERED PROFESSIONAL LAND SURVEYOR
David H Krumbein
OREGON JULY 17, 1970 DAVID H. KRUMBEIN 933

Sheet 1 of 3

P. 91 -B

KRUMBEIN ENGINEERING CO.
ENGINEERS – SURVEYORS – PLANNERS
221 S. Main, Pendleton, Oregon

Survey for
U.S. FOREST SERVICE
Section 31, T6S, R33E W.M.

SCALE	1"=500'
DATE	Sept 6, 1978
DRN BY	TAG
CKD BY	TEH
DRNG NO	78-612

2+3 not received

Job No. 78-58