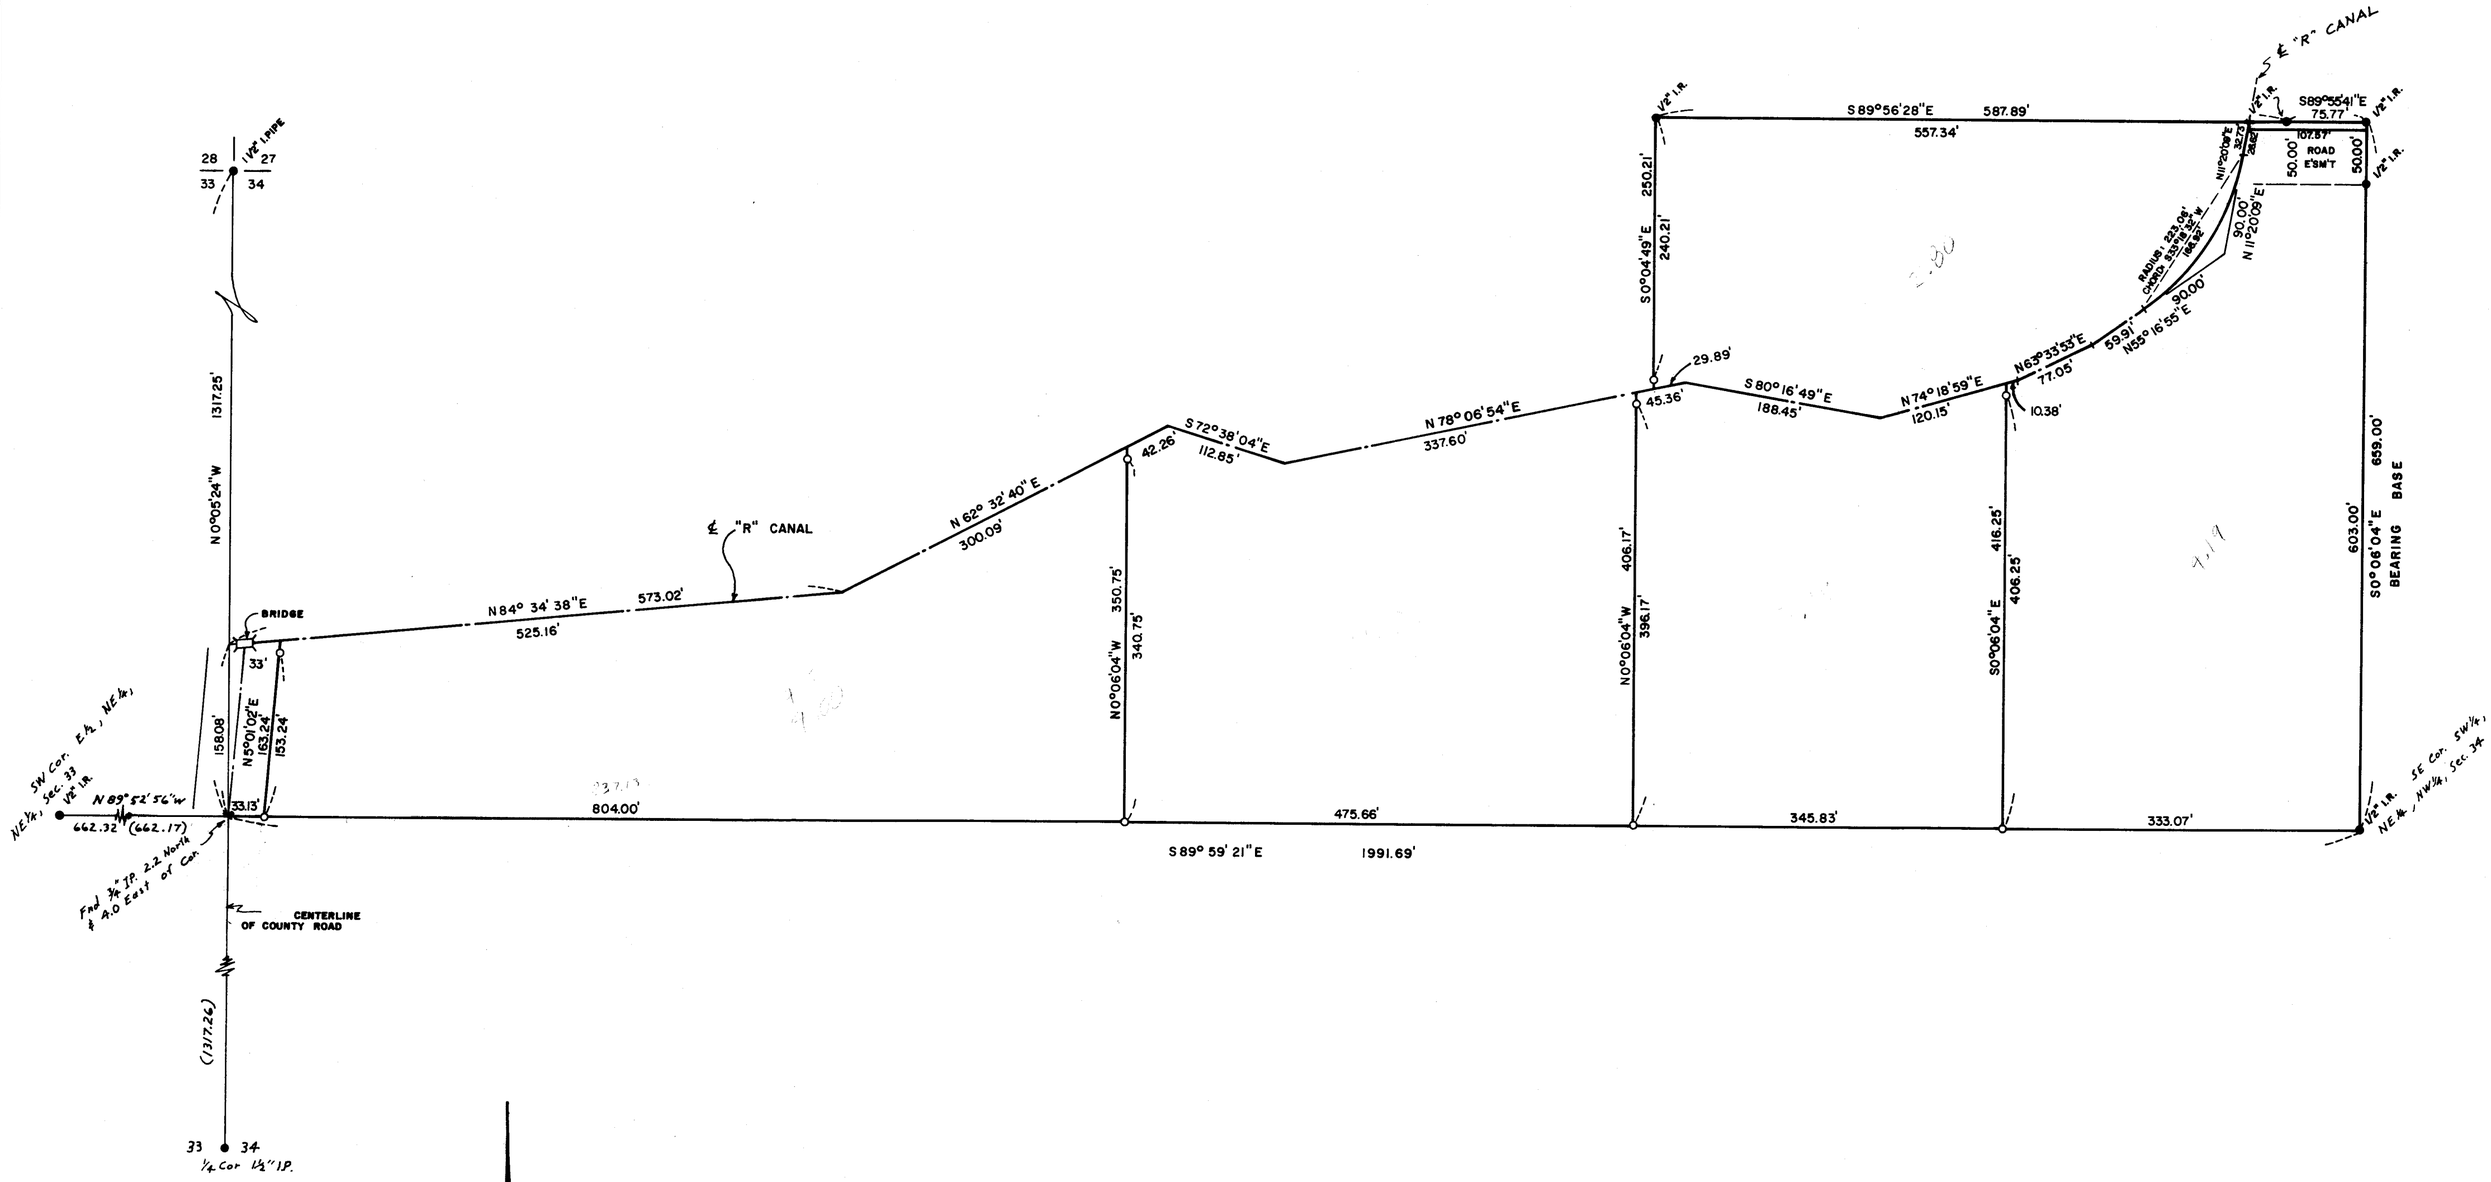

P-129-B

REGISTERED PROFESSIONAL LAND SURVEYOR

G. Dennis Edwards

OREGON
JULY 16, 1971
G. DENNIS EDWARDS
951

SURVEY FOR: **WOODY STARRETT**

LOCATION: NW 1/4 of SEC. 34, T5N, R28E, W.M., UMATILLA COUNTY, OREGON

DATE: 9-4-78 | SCALE: 1" = 100'

● MONUMENTS FOUND | (000) OF RECORD

○ 1/2" IRON RODS SET | JOB NO. S7808307

EDWARDS SURVEYING
567-3336

P.O. BOX 763
HERMISTON, OREGON