



CHM
2011/12

17
20
16
21

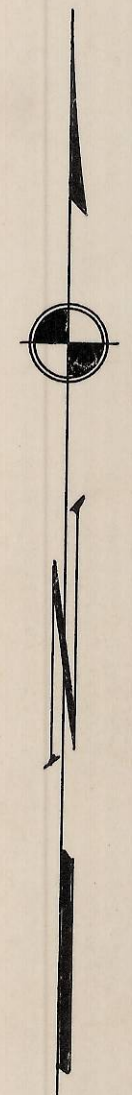

Q-437-B

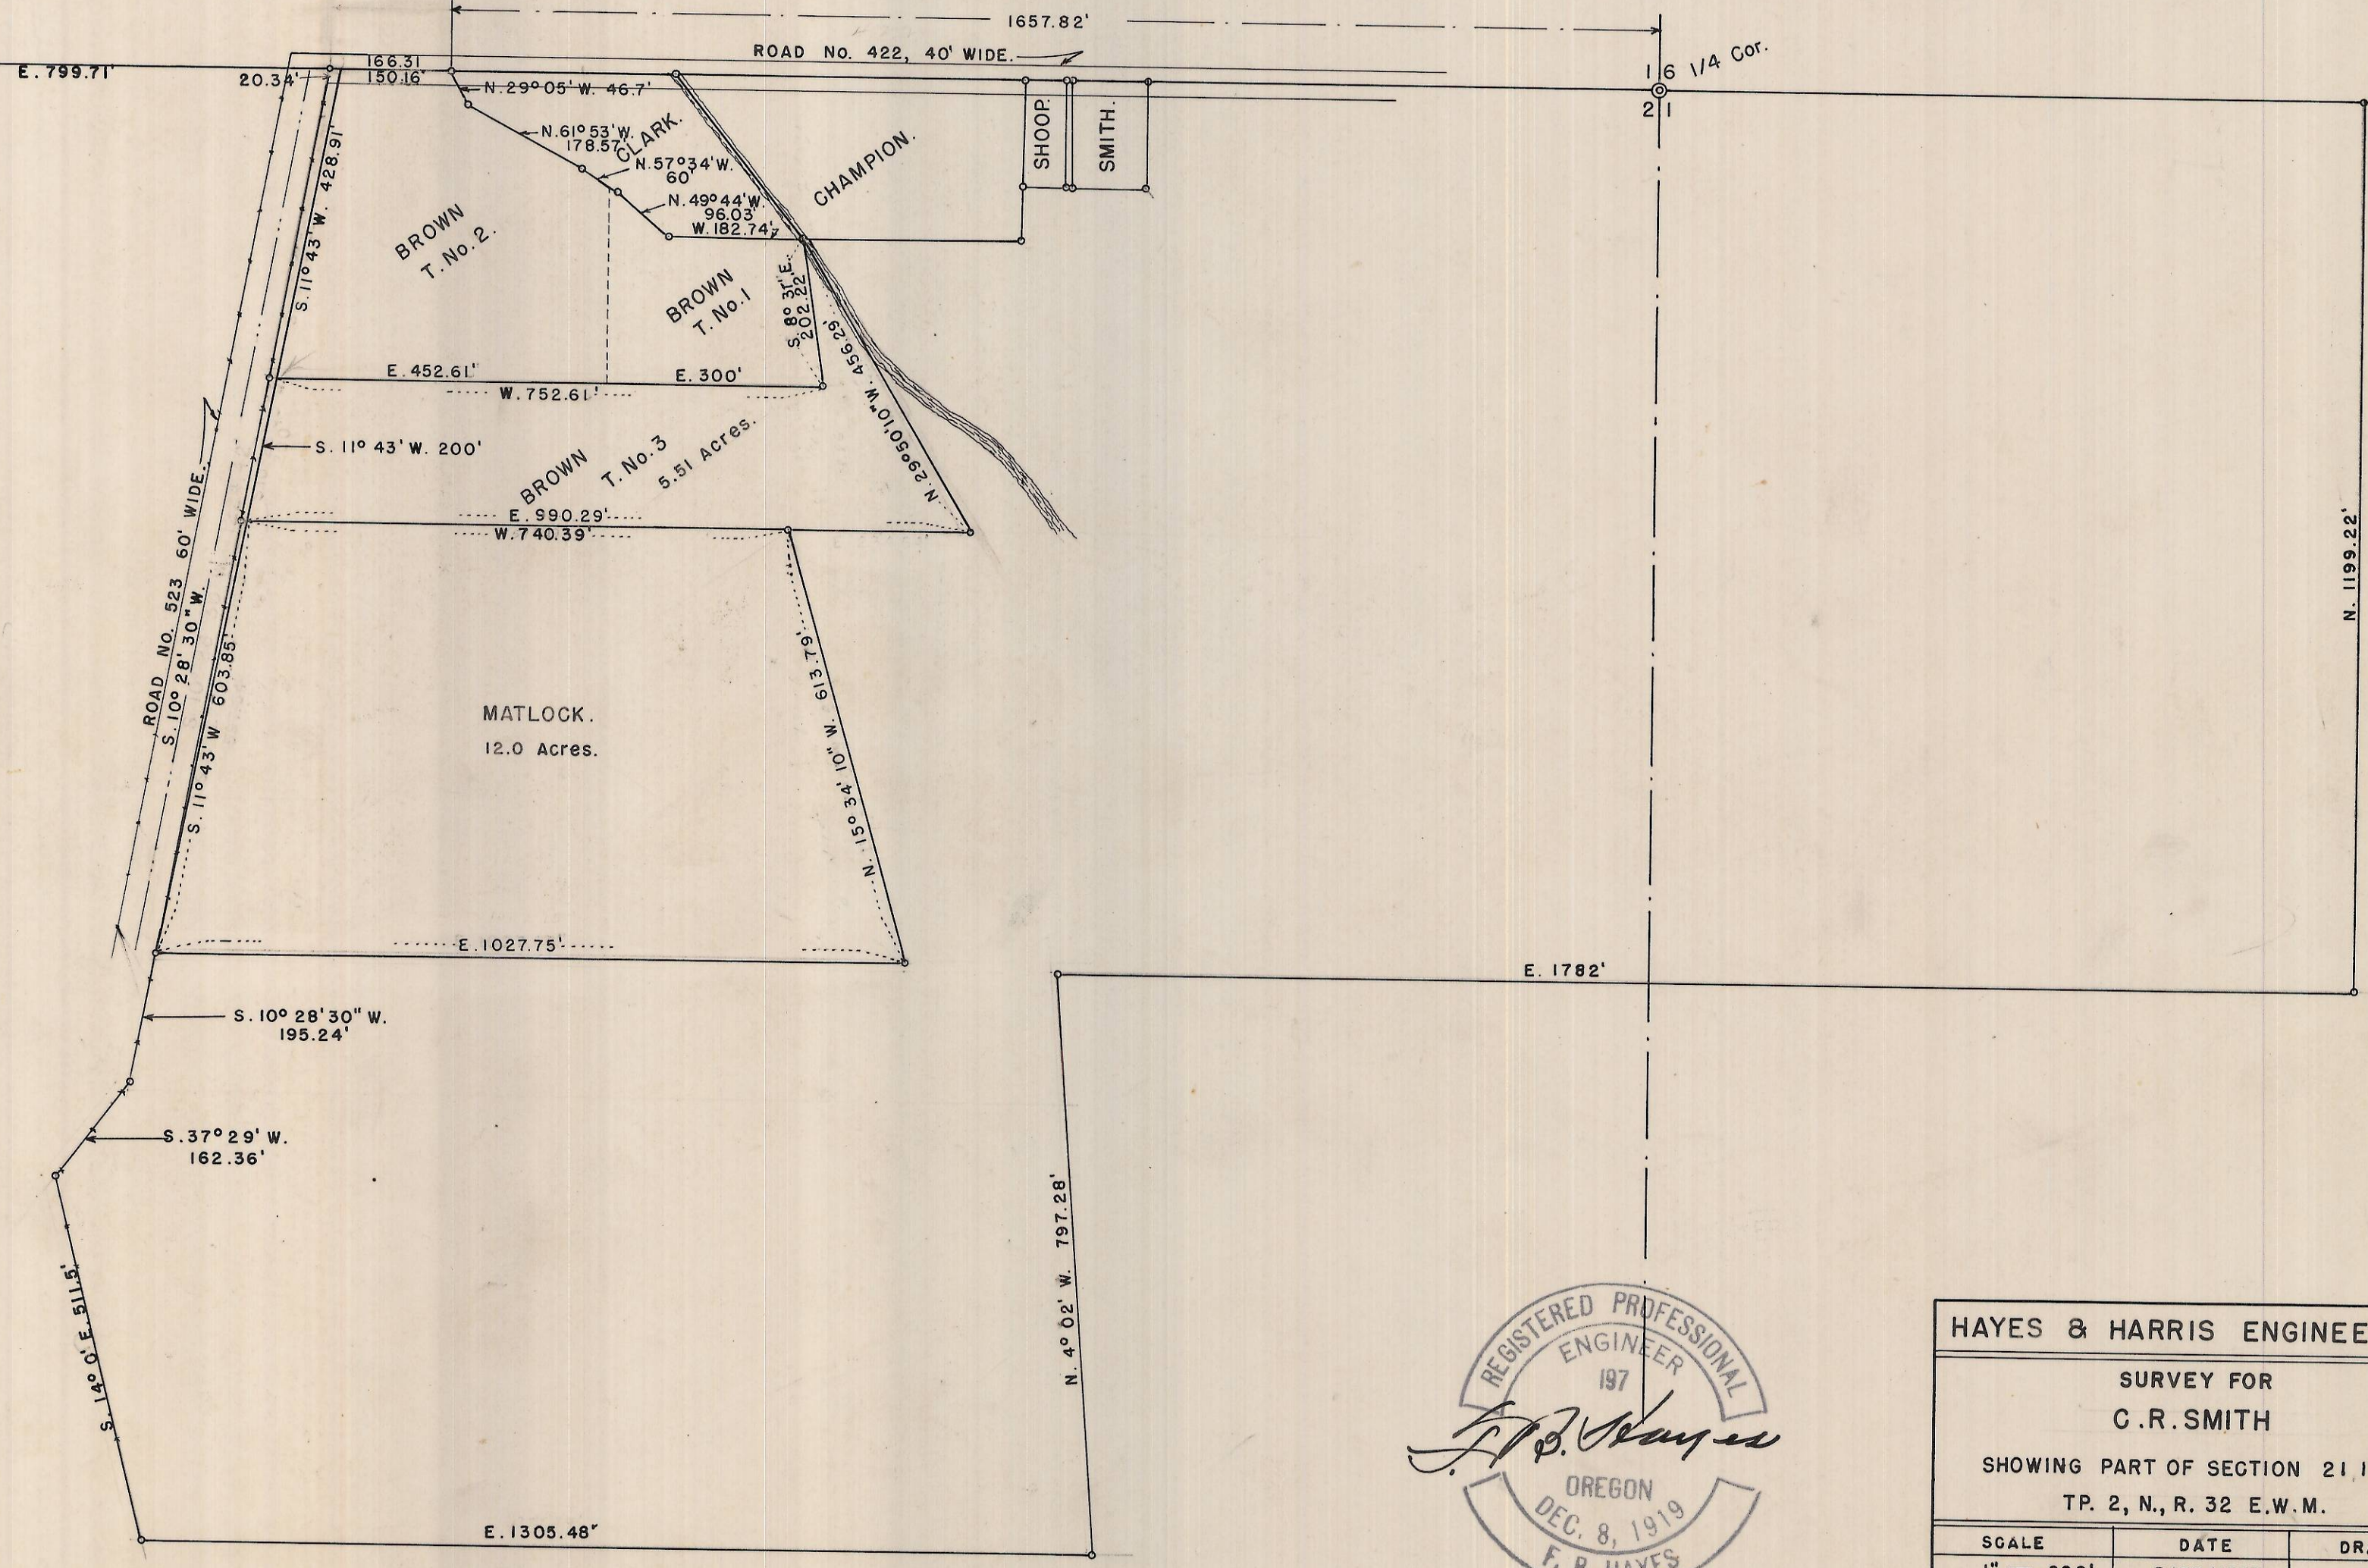

HAYES & HARRIS ENGINEERING		
SURVEY FOR C. R. SMITH		
SHOWING PART OF SECTION 21 IN TP. 2, N., R. 32 E.W.M.		
SCALE	DATE	DRAWN BY.
1" = 200'	5/20/1955	F. B. H.

Q-437-B