



Q-610-B

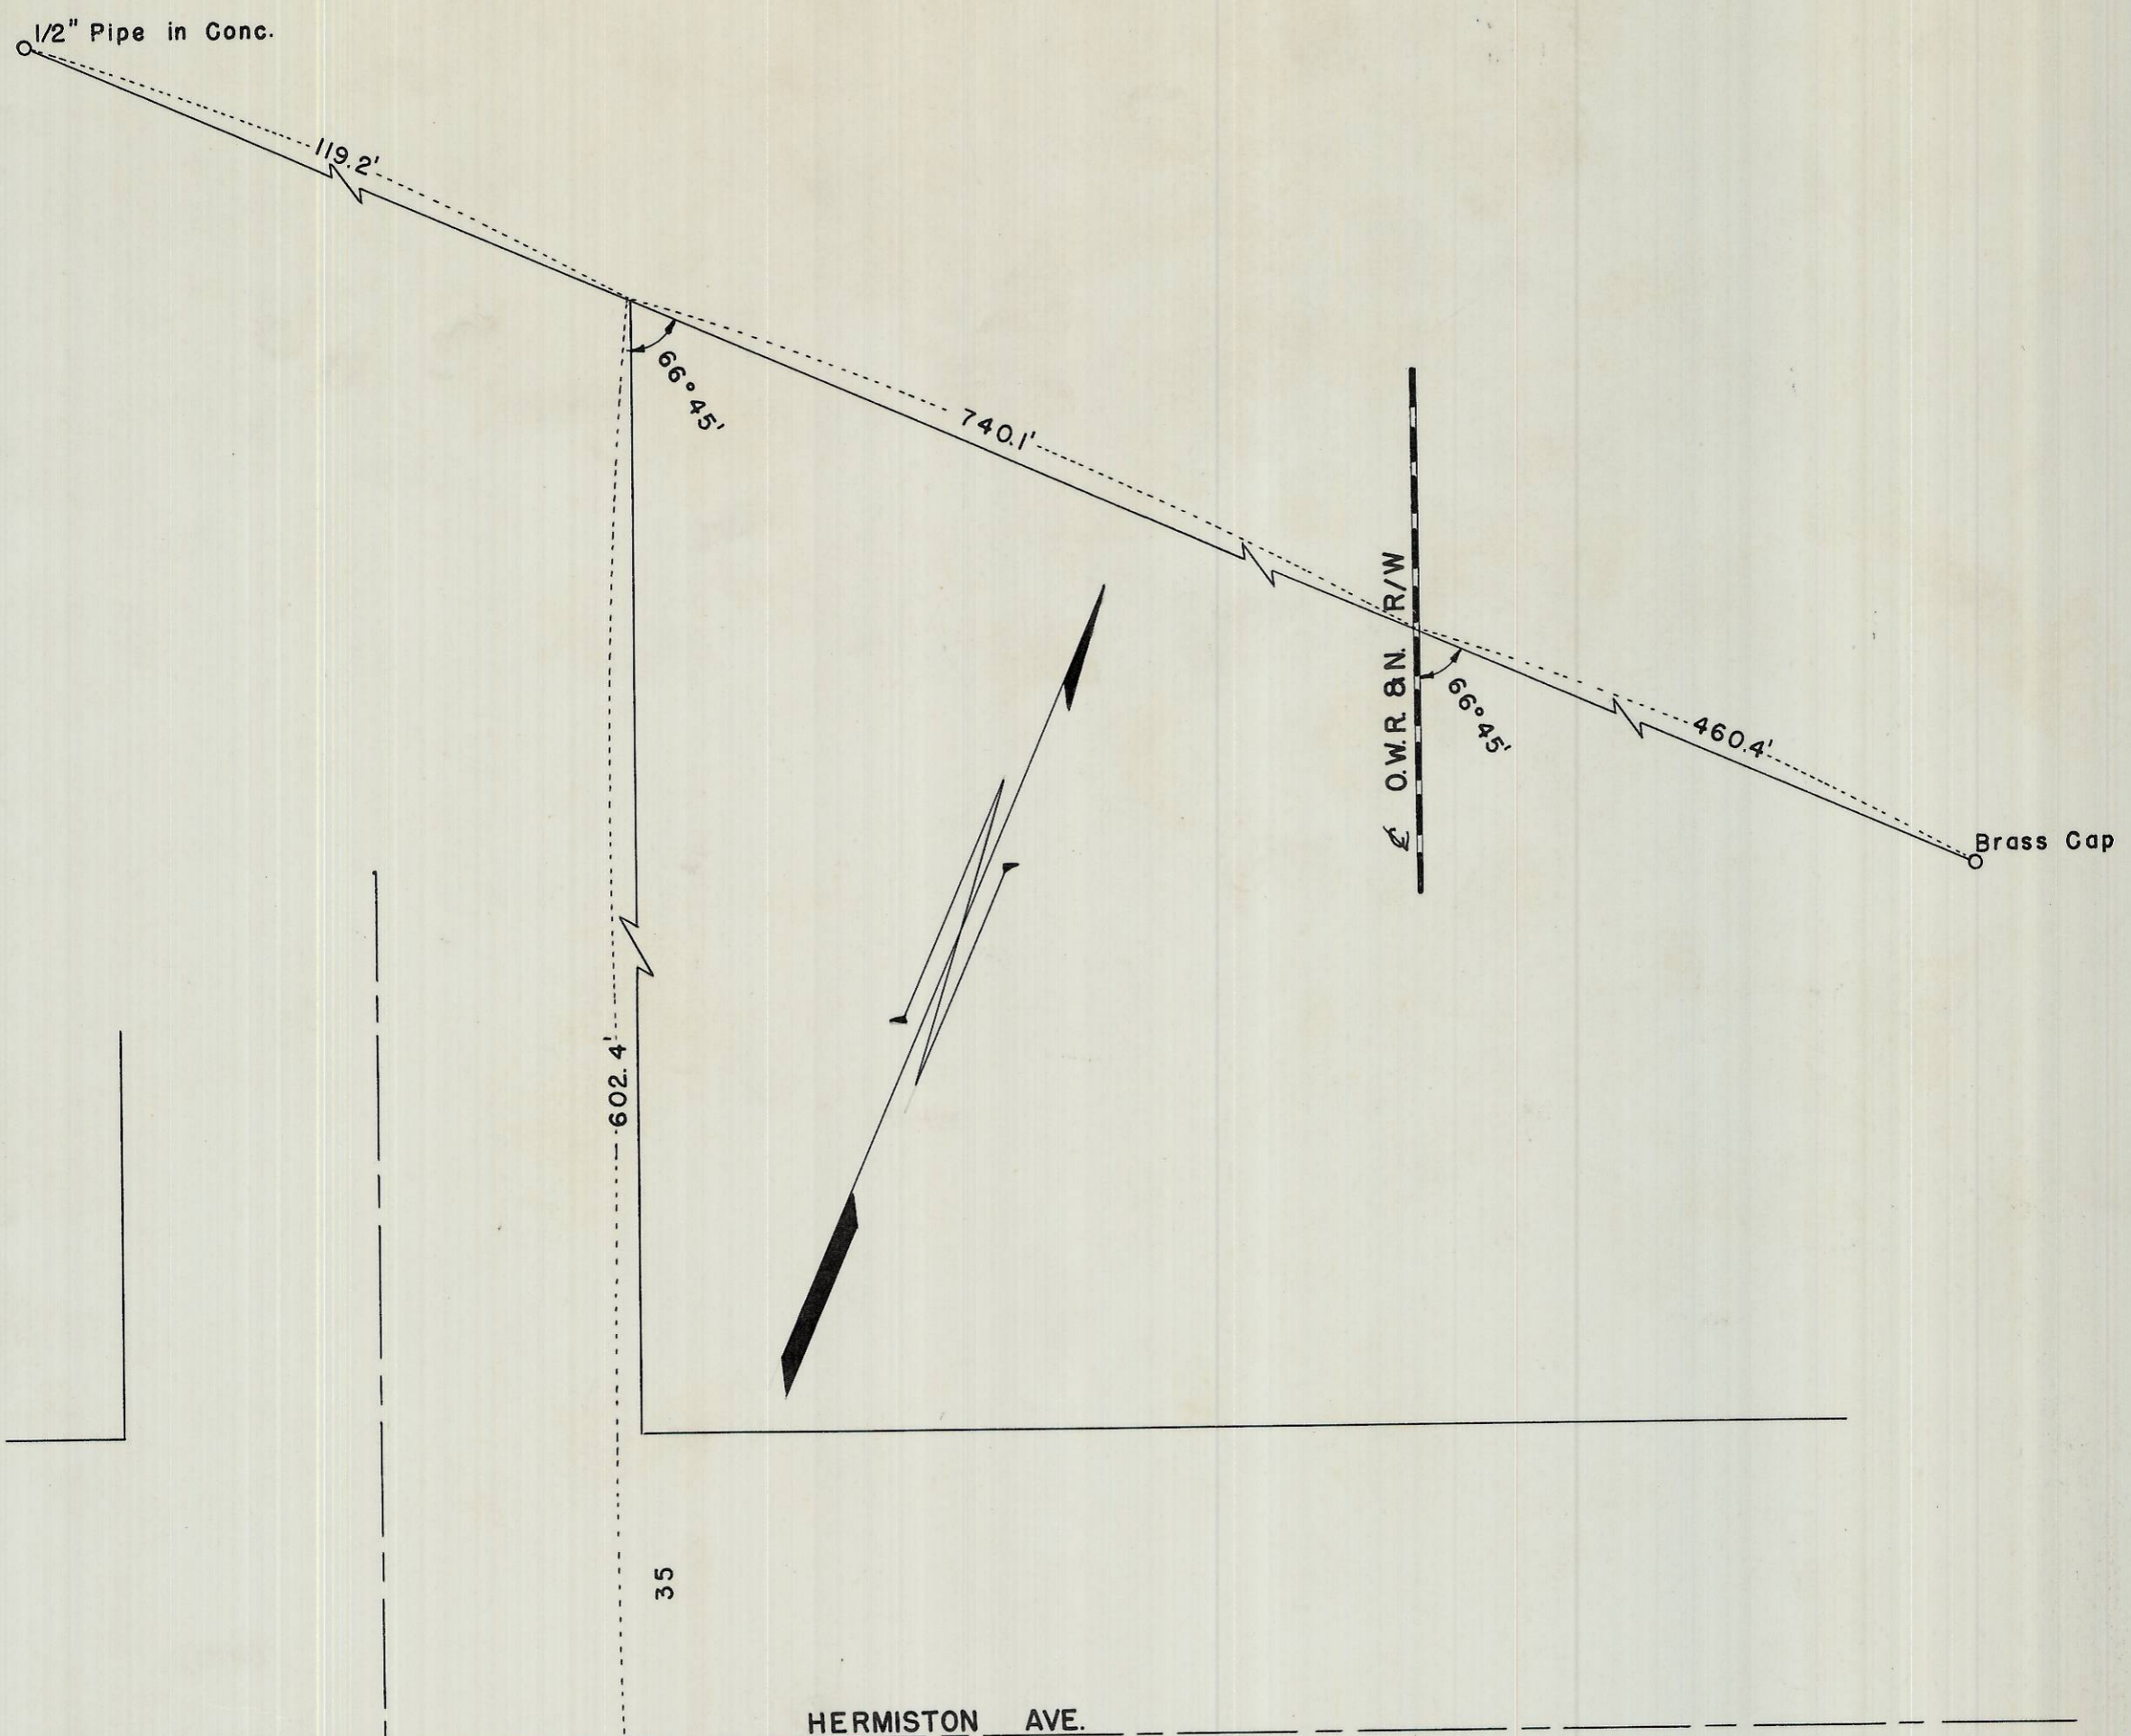

HERMISTON AVE.

THIRD ST.

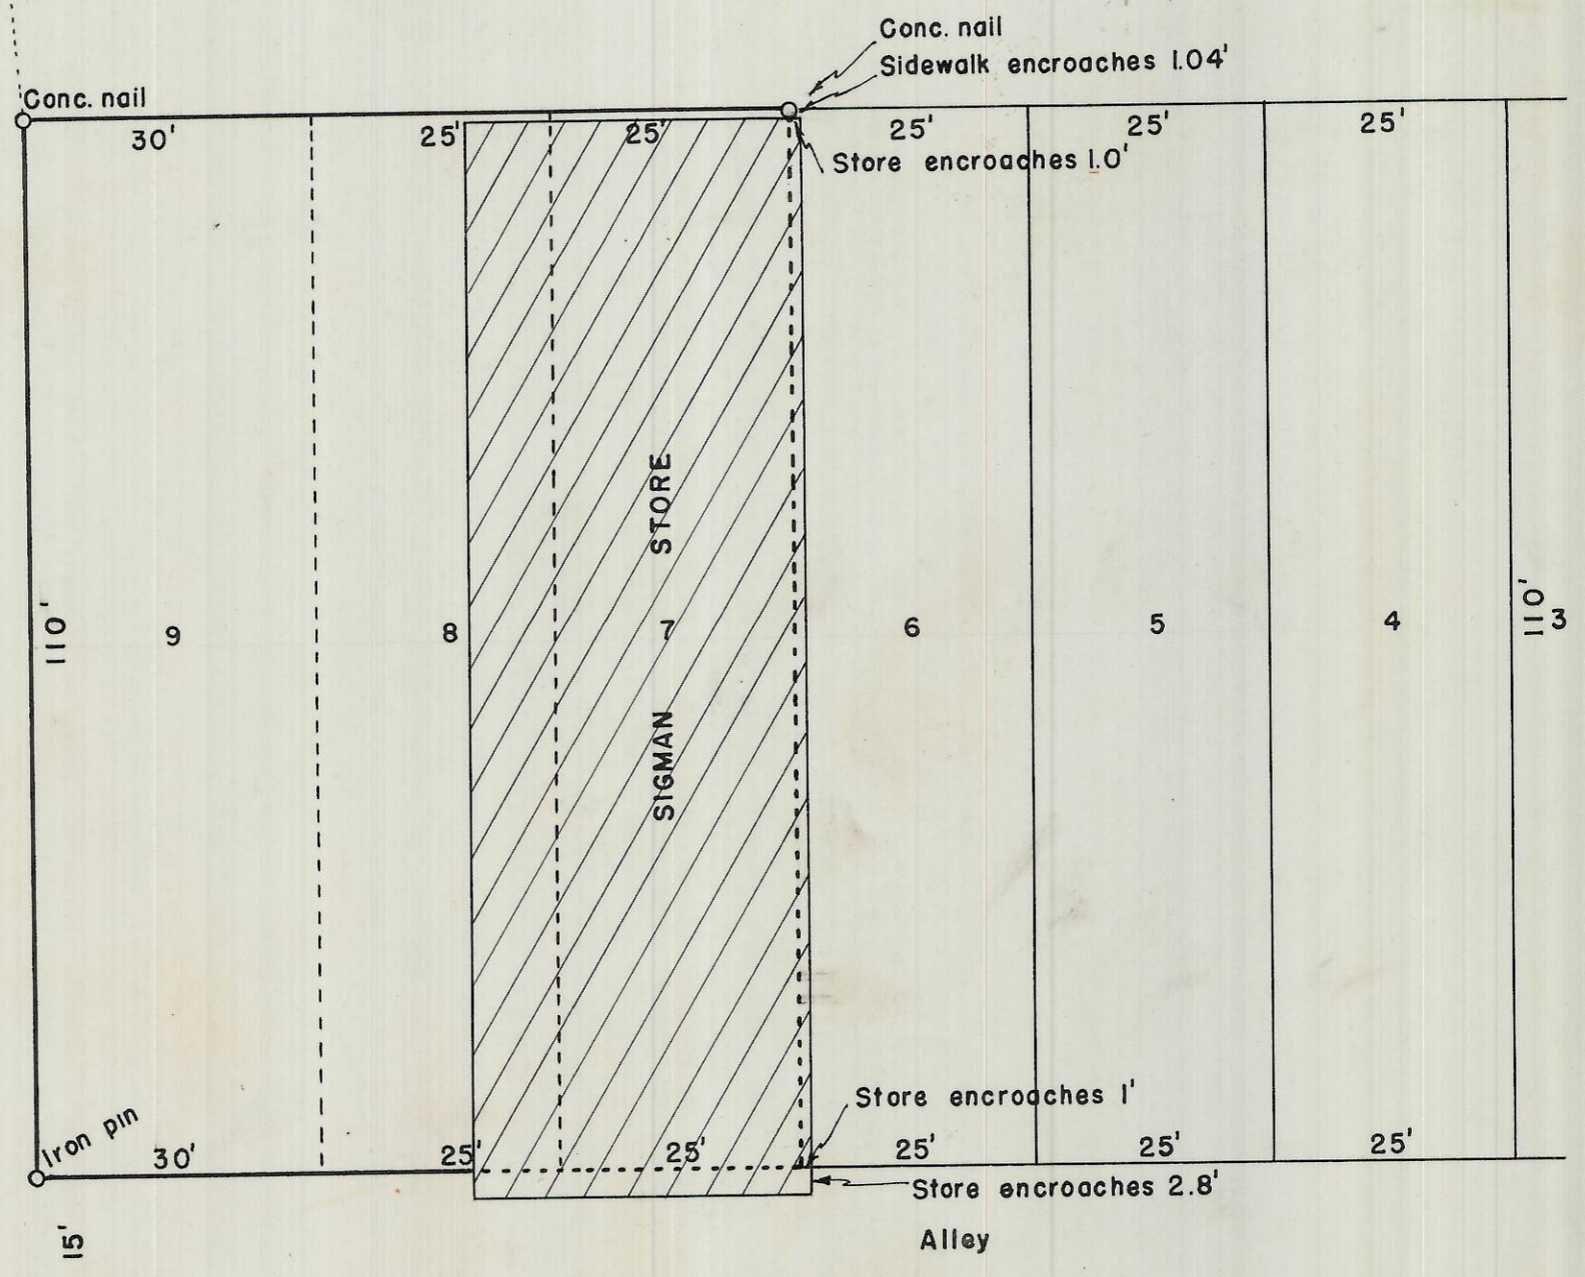

7

REGISTERED OREGON LAND SURVEYOR

Wayne O. Harris

MAY 6, 1955 WAYNE O. HARRIS 346

HAYES & HARRIS ENGINEERING

SURVEY FOR SIGMAN FOOD STORES LOTS 7, 8 & 9, BLK. 7 MAXWELL ADDITION HERMISTON, OREGON

| SCALE | DATE | DRN. BY | DRNG. NO. |
|----------|---------|---------|-----------|
| 1" = 50' | 2-27-56 | W.O.H. | |

4N 28 10D

Q-610-B