
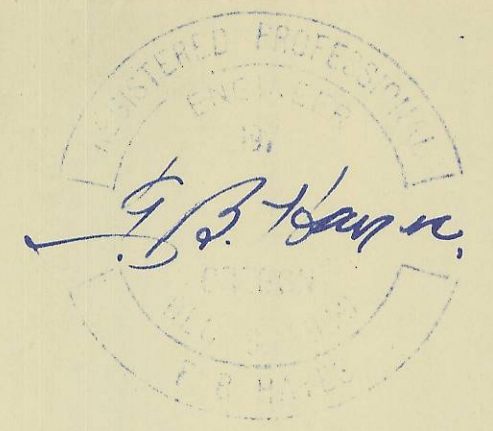


I, F.B. Hayes, County Surveyor for Umatilla County, do hereby certify that this map was made from notes taken during an actual survey made by me on September the 5th 1953; that the monument or 1/4 corner was destroyed and and that I relocated said corner and drove a 1" I.P. the top of which is 6" below the surface of the ground. The bearing of well from said 1/4 corner is N. 41° 55' 30" E. 1439.3 feet. Total acres irrigatable 195.75

F.B. Hayes
COUNTY SURVEYOR.

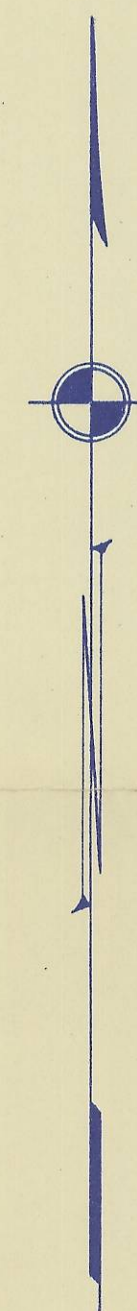

PLAT OF SURVEY
FOR
L.L. ROGERS.
LOCATION OF DEEP WELL
AND LAND TO BE IRRIGATED.
LOCATED IN THE SE¹/₄ OF SECTION 33
T. 4 N., R. 34 E.W.M.
Scale 1" = 200'

*9-700-8
PLAT*