



WATER MAIN
4.8

City Monument MAIN ST.

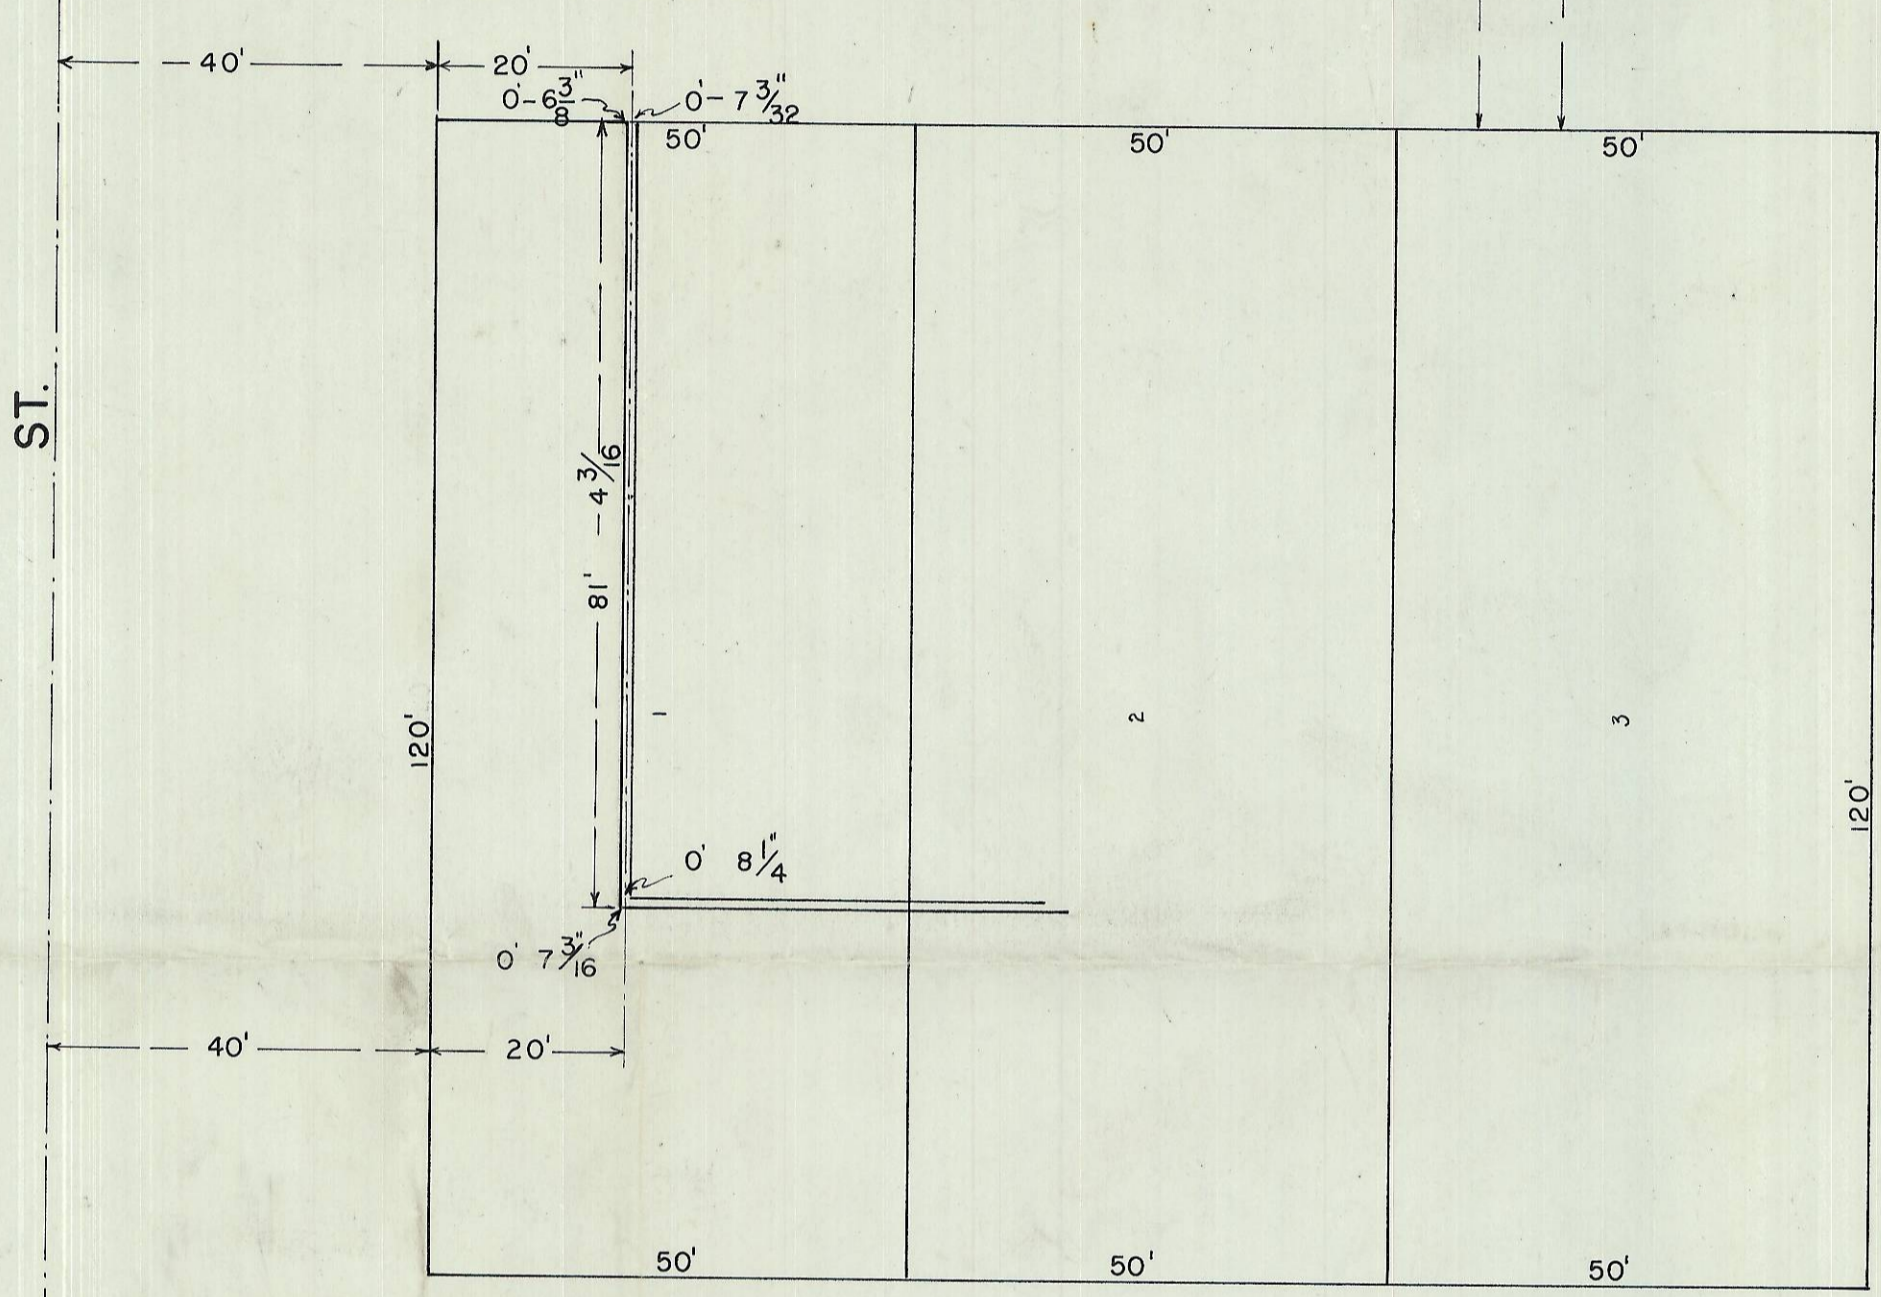

ST.

THIRD

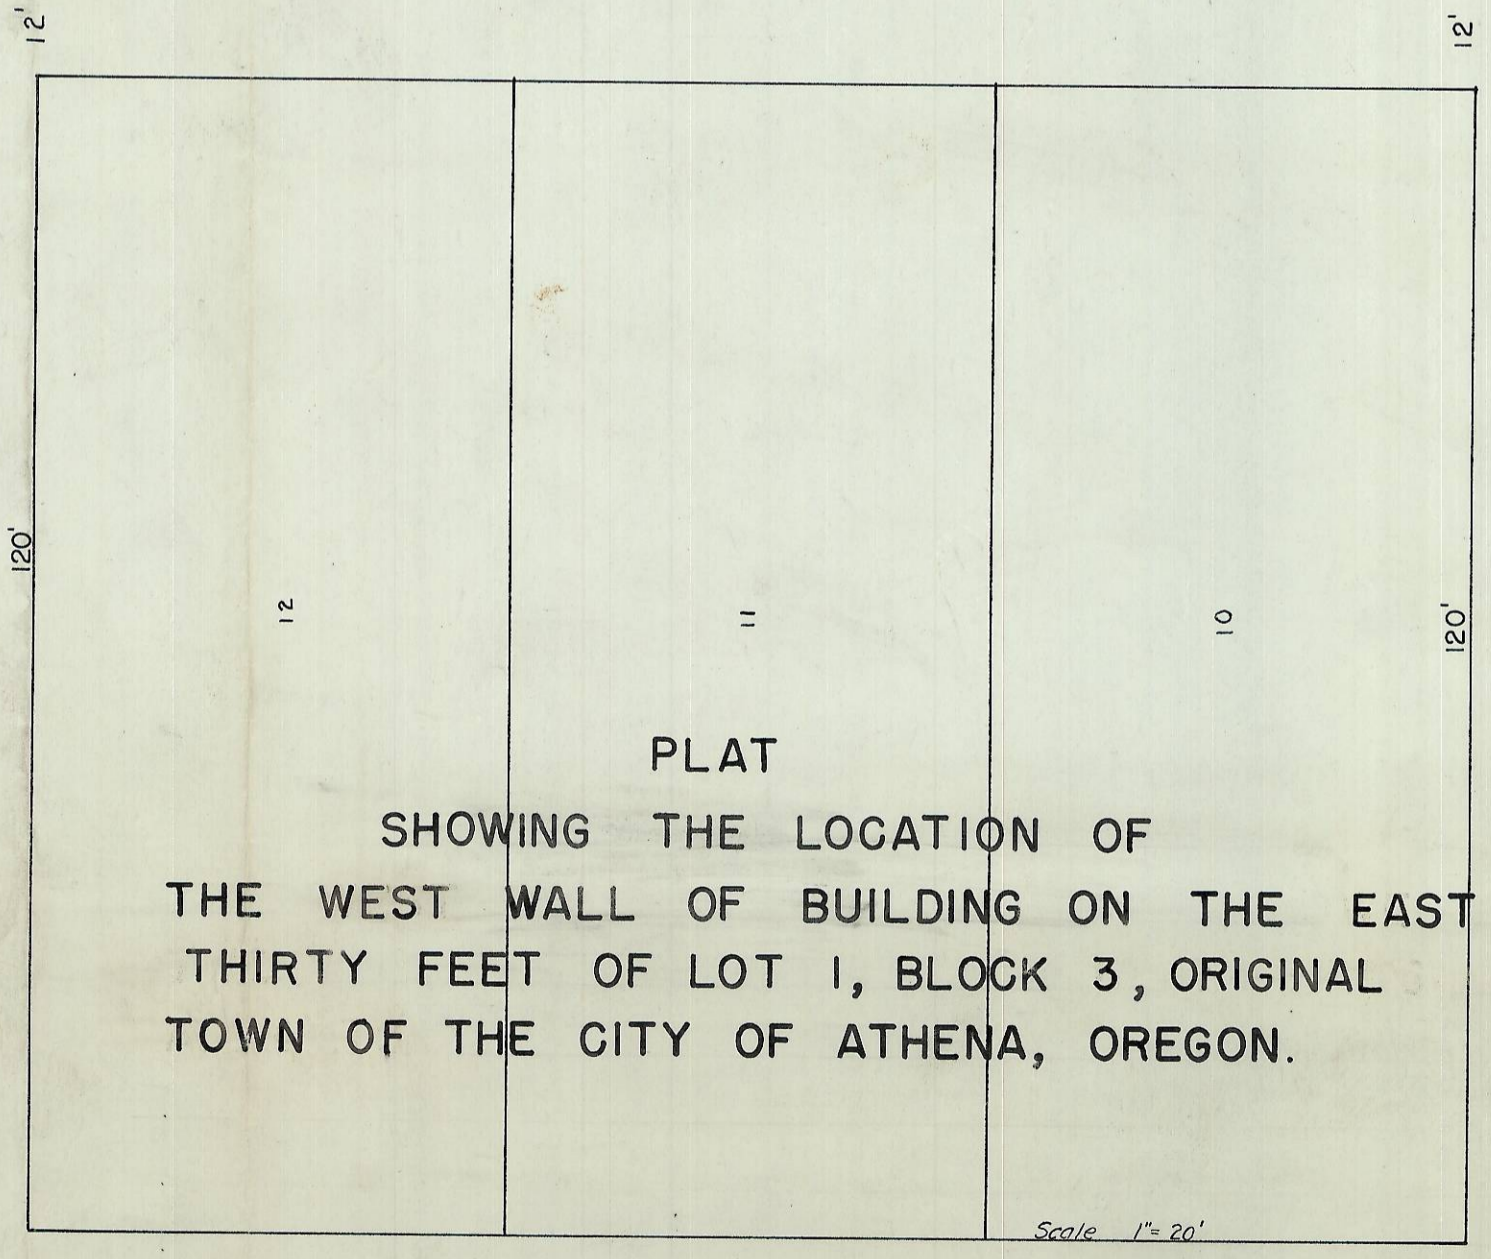

PLAT
SHOWING THE LOCATION OF
THE WEST WALL OF BUILDING ON THE EAST
THIRTY FEET OF LOT 1, BLOCK 3, ORIGINAL
TOWN OF THE CITY OF ATHENA, OREGON.



Scale 1" = 20'

Q-1253-B
40 35 19c

Q-1253

5