
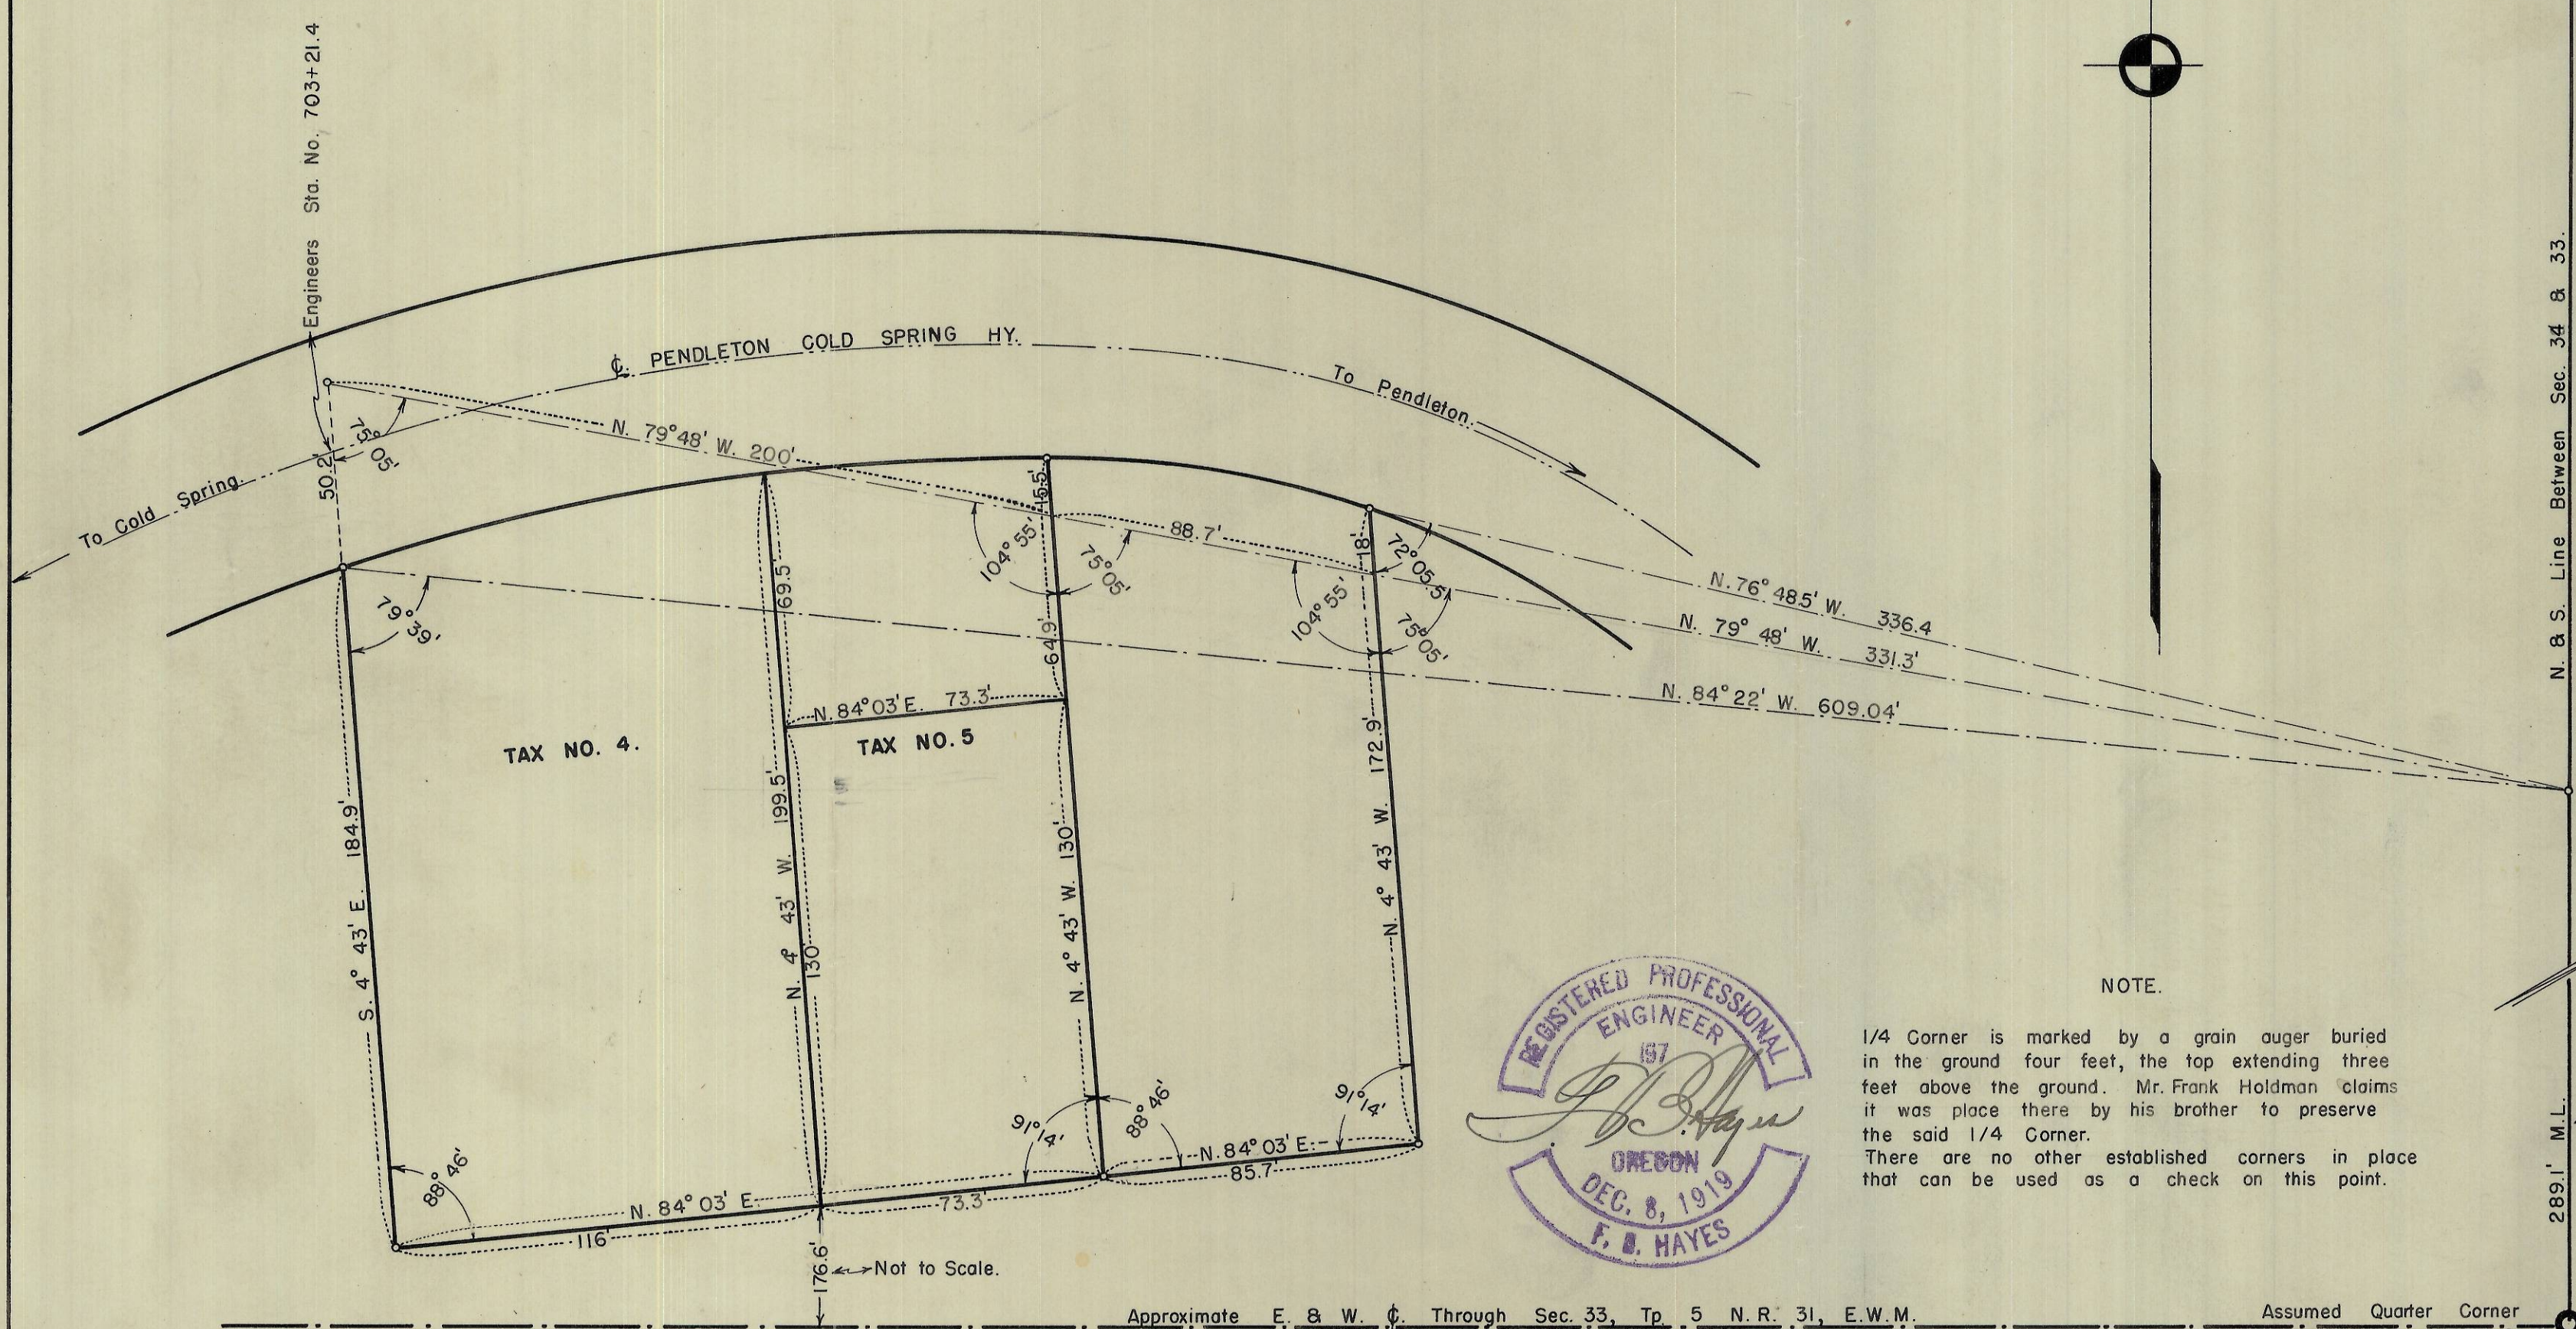


PLAT
OF
TAX NUMBERS FIVE & FOUR.
SECTION 33, T. 5, N.R. 31 E.W.M.

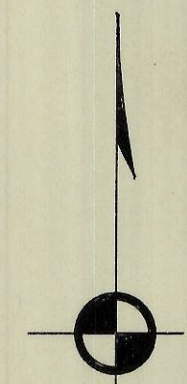

NOTE.

1/4 Corner is marked by a grain auger buried in the ground four feet, the top extending three feet above the ground. Mr. Frank Holdman claims it was place there by his brother to preserve the said 1/4 Corner. There are no other established corners in place that can be used as a check on this point.

NOTE.

This Line Is not To Scale.

Approximate E. & W. C. Through Sec. 33, Tp. 5 N.R. 31, E.W.M.

Assumed Quarter Corner
Between Sections 33 & 34

Scale 1" = 40'

N. & S. Line Between Sec. 34 & 33.

289.1' M.L.

Q-1269

18015
5103
816
②