


LANDS OF GROVER

EAST-WEST CENTERLINE OF SECTION 35

FOUND BRASS CAP MARKED:

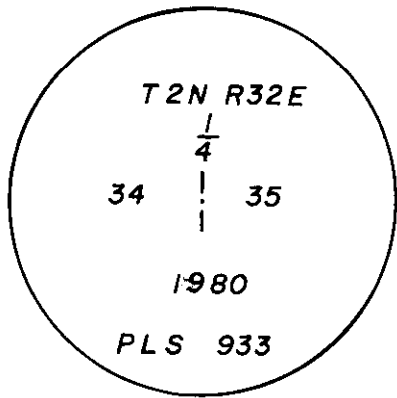


FENCE ON PROPERTY LINE

WEST LINE OF SECTION 35

20.0 ACRES M/L

LANDS OF WHITNEY

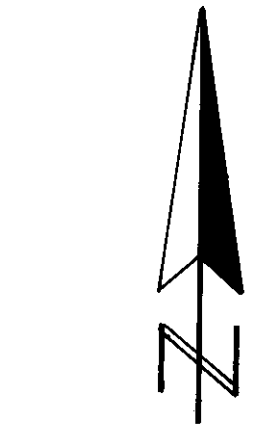

SCALE: 1" = 100'

BASIS OF BEARINGS:
THE WEST LINE OF SECTION 35 EQUALS S0°04'00"E

LEGEND

- FOUND MONUMENT OF RECORD
- ⊙ SET 5/8" X 30" IRON PIN
- SET HUB & TACK AS NOTED
- (00) RECORD DISTANCE

MAP REFERENCES FROM THE
UMATILLA CO. SURVEYORS OFFICE

MAP NO. H-251-B

MCKAY NATIONAL WILDLIFE BOUNDARY

1649.65' (1650.00')
(BEARING BASE)
S 0°04'00" E


OLD ROAD

SET H&T 6.68' NORTH OF P.L.

N 89°56'00"E 880.00'

LANDS OF WHITNEY

FOUND BRASS CAP MARKED:

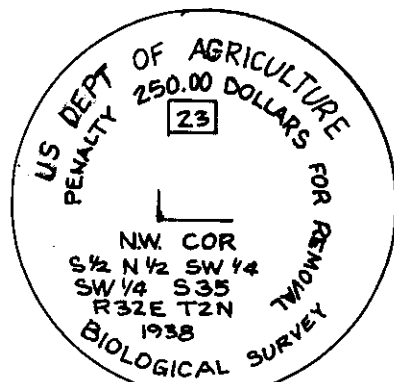

REGISTERED PROFESSIONAL LAND SURVEYOR

William R. Wells
OREGON
JULY 22, 1977
WILLIAM R. WELLS
1106

RECEIVED BY
Umatilla County Surveyor
Date 9-80
Issued by BLS
No. H-161-B

WALLULIS PROJECT NO:
80-117
AGENCY PROJECT NO:

PROJECT:
SURVEY FOR:
GARY JELLUM LOCATED IN
THE SW 1/4 OF SECTION
35 TOWNSHIP 2 NORTH
RANGE 32 EAST W.M.
UMATILLA COUNTY, OR.

WALLULIS & ASSOCIATES, INC.
ENGINEERING & PLANNING
5 S E NYE AVENUE 108 EAST MAIN
PENDLETON OREGON 97801 HERMISTON OREGON 97838
503 276 1598 503 567 3331

SCALE: 1" = 100'
DATE: JULY 11, 1980
DES BY: G.E.F.
DR BY:
CK BY: W.R.W.

TITLE:

REVISIONS

DRAWING:

SHEET OF