


NOTE

Bearings are based on a survey by Krumbein Engineering Co. for Henry Lembocke, dated November 21, 1977, County Survey Records drawing no. R-175-B.

The distance of 705.00 feet along Columbia Street is based off the deed records, Book 59, Page 35, Deed Records of Umatilla County, Oregon.

- denotes monument found as noted
- denotes 5/8 in. iron pin with aluminum cap set
- denotes Rk. nail set
- () denotes record distance

Ind. 5/8" i. pin ODS south set by Wayne Harris Co. May 21, 1980, Co. drawing no. B-117-B

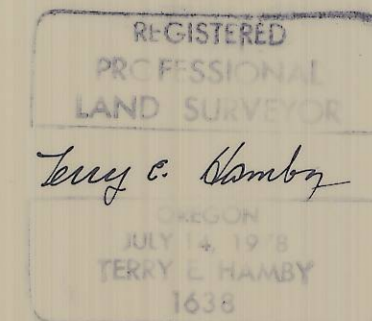

RECEIVED BY
 Umatilla County Surveyor
 Date 4-81
 Rec'd By BLS
 No. S-51-B

K	REGISTERED PROFESSIONAL LAND SURVEYOR	SCALE 1" = 50'
Survey for HENRY LEMBCKE		DRN. BY NA
NE 1/4, NW 1/4, Section 11, T41N, R33E, Helix, Oregon		CKD BY TEH.
		DRNG. NO. 80-50C