


E-5

E-5

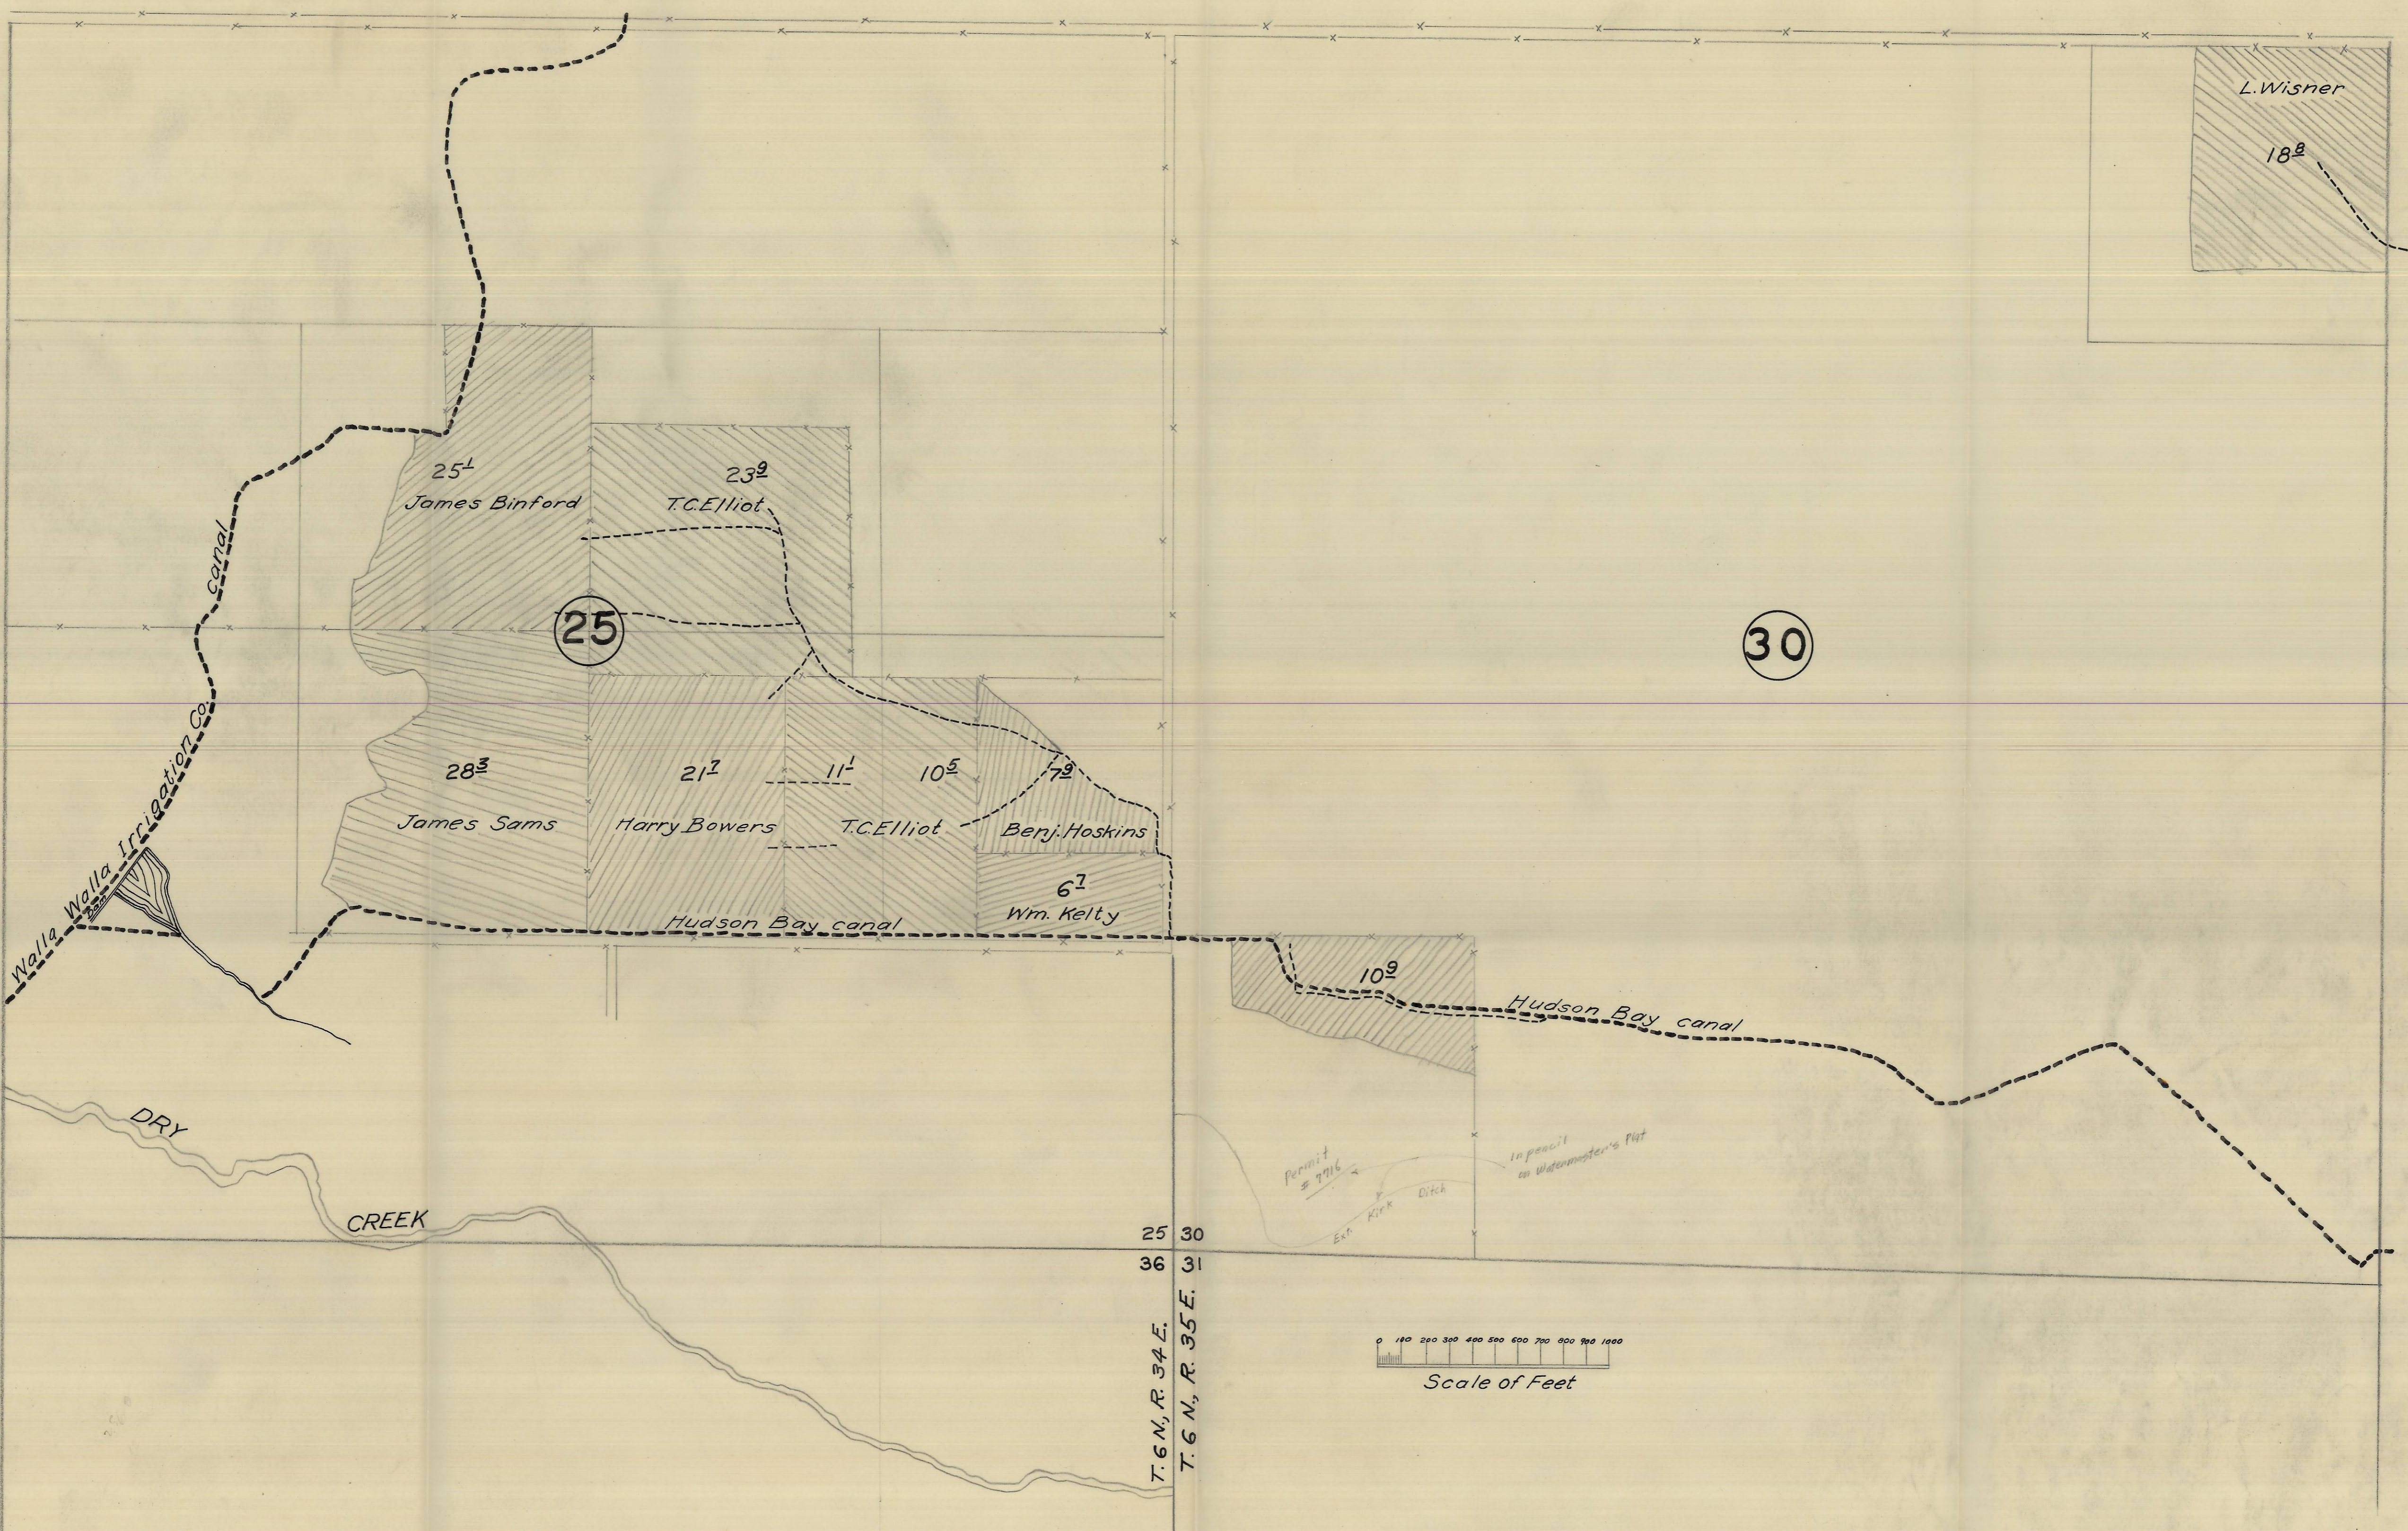

Circle
m/s
D/W

E-5

E-5
7

07-64c