


Point on Southerly R/W Line of U.P.R.R. By Deed. (I Believe this is incorrect.) F.B.H.

TRACT NO. 1 O.K.

TRACT NO. 2 INDEFINATE.

This Survey made from descriptions furnished me are indefinite TRACT NO. 1 IS GOOD. TRACT NO. 2 IS NOT DEFINATE.

Scale 1"=100'

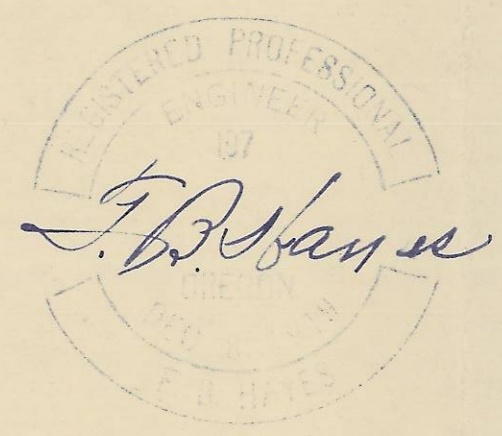

2032 8
07-120-C

N. & S. 1/4 Line through center of Section 8, T. 2 N., R. 32 E. W. M.