
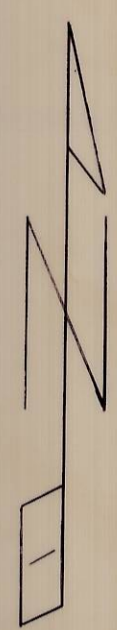


W.C. NORTH 737-517.66
EAST 2-469-798.10

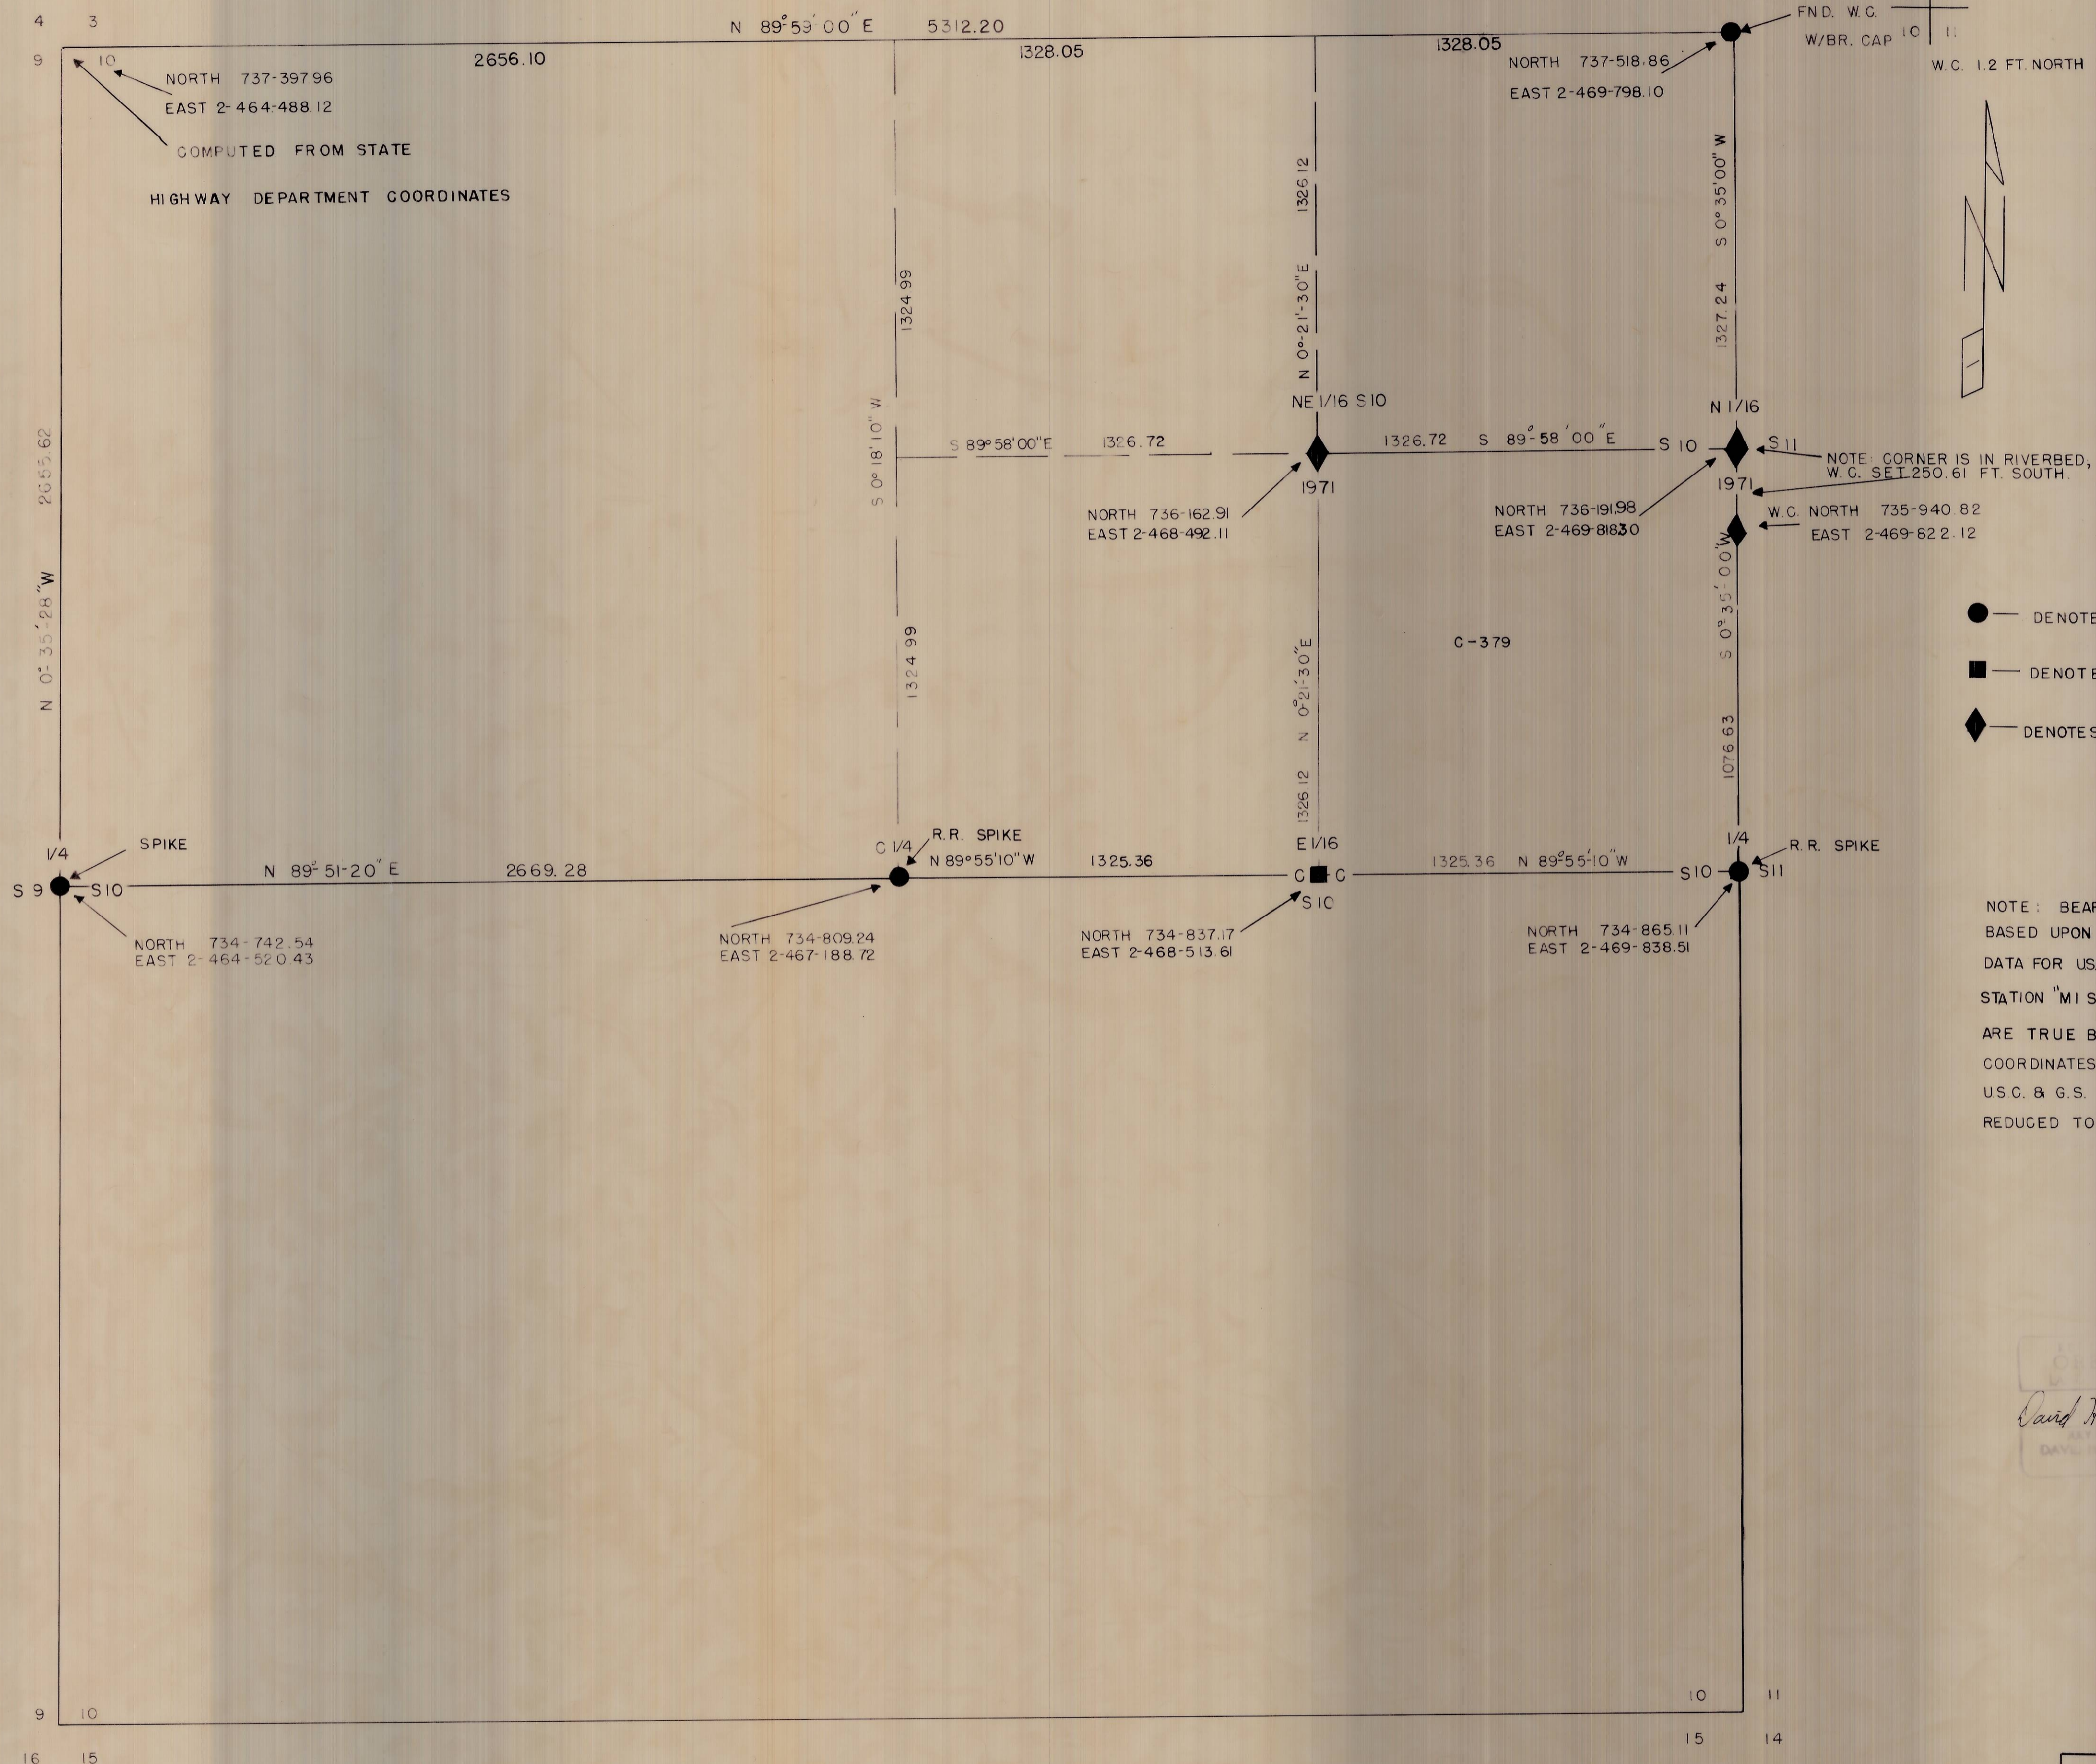

- DENOTES MONUMENTS FND.
- DENOTES R.R. SPIKE SET
- ◆ DENOTES 1/2" STEEL PIPE W/ BR. CAP SET

NOTE: BEARINGS ARE BASED UPON PRELIMINARY DATA FOR USC. & GS. STATION "MISSION" THEY ARE TRUE BEARINGS. COORDINATES SHOWN ARE USC. & G.S. "OREGON NORTH ZONE" REDUCED TO SEA LEVEL.

David H. Kumbier
DAVID H. KUMBIER

H 227

WAYNE O. HARRIS & ASSOCIATES			
SURVEY FOR			
BUREAU OF INDIAN AFFAIRS			
SE 1/4, NE 1/4, Sec. 10, T2N, R33E, W.M.			
DATE	SCALE	DRN BY	DRNG NO.
2-24-71	1" = 300'	DNS	261-G