


BEARINGS ARE BASED ON 1973 KRUMBEIN SURVEY

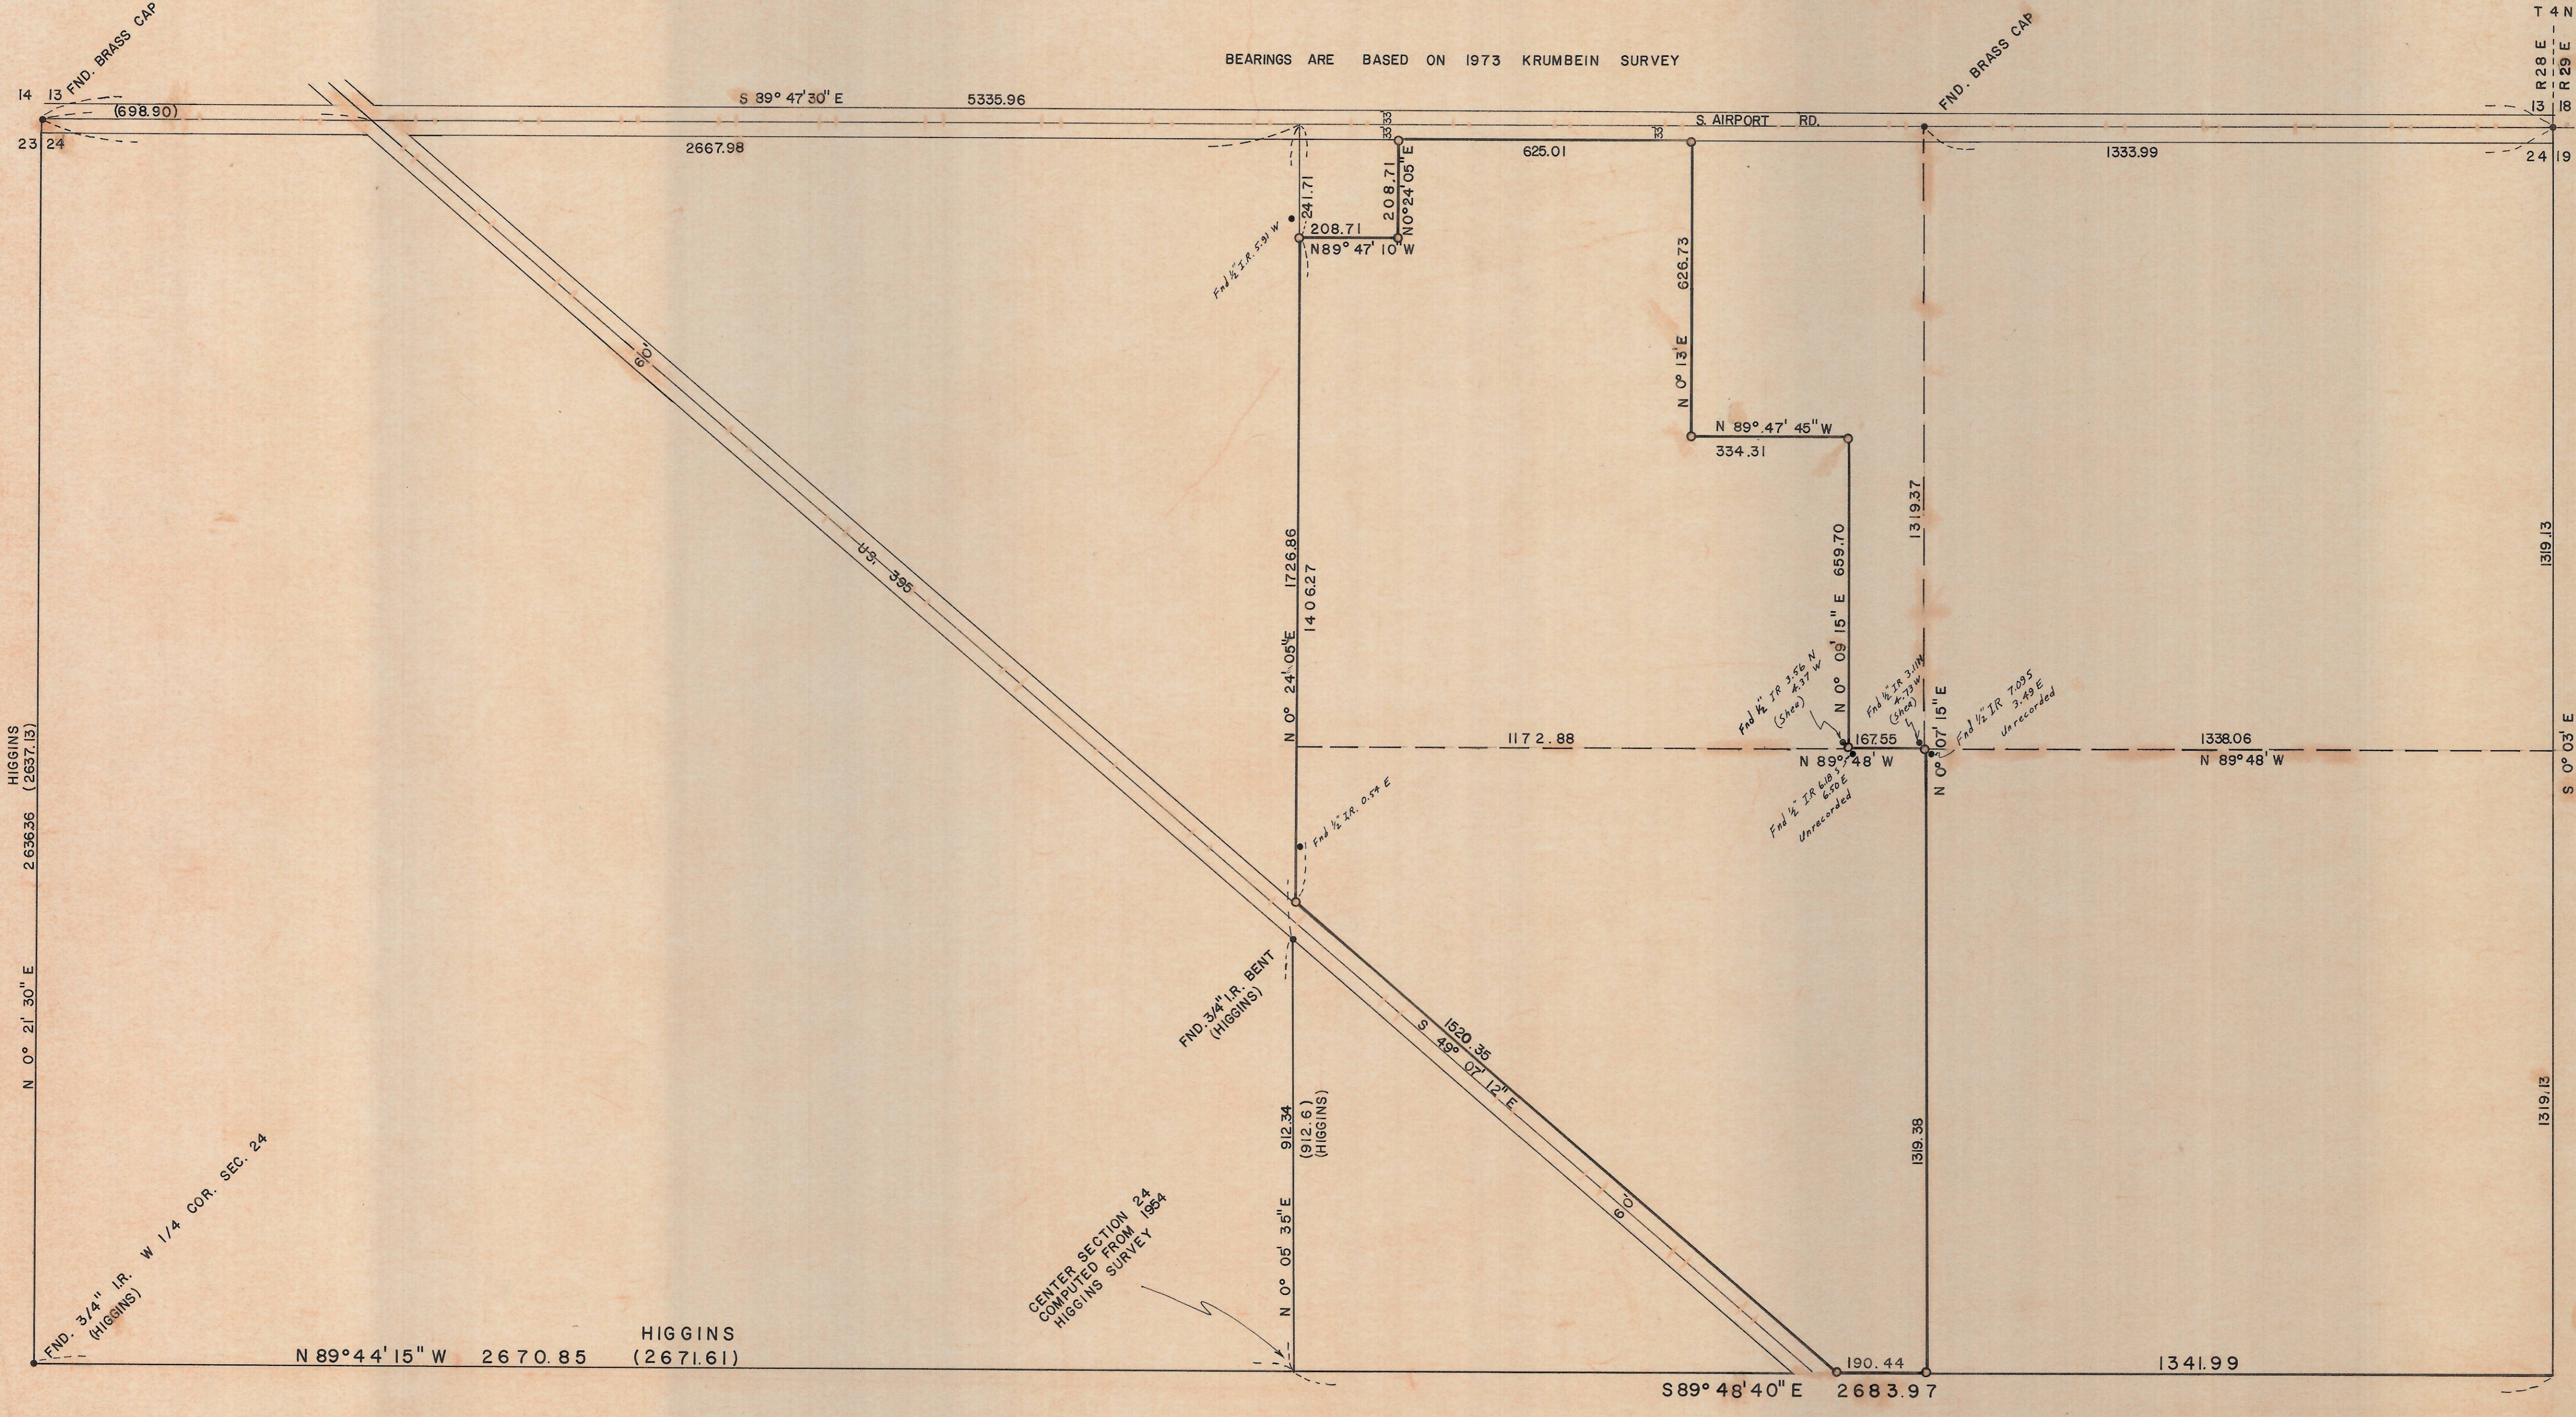

SCALE 1" = 200'

- LEGEND**
- MONUMENTS FOUND
 - 1/2" I.R. SET
 - (000) OF RECORD
 - PROPERTY LINE
 - SECTION & 1/4 LINES
 - - - 1/16 LINES
 - DIMENSION & R/W LINES
 - - - CENTER LINE

HIGGINS
(2637.13)
2636.36
N 0° 21' 30" E

FND. 3/4" I.R. (HIGGINS)
W 1/4 COR. SEC. 24

HIGGINS
(2671.61)
2670.85
N 89° 44' 15" W

CENTER SECTION 24
COMPUTED FROM 1884
HIGGINS SURVEY

E 1/4 COR. SEC. 24
COMPUTED FROM KRUMBEIN SURVEY

REGISTERED
PROFESSIONAL
LAND SURVEYOR
G. Dennis Edwards
OREGON
JULY 16, 1971
G. DENNIS EDWARDS
951

SURVEY FOR			
WES		CRUIKSHANK	
G. DENNIS EDWARDS HERMISTON, OREGON			
DESIGNED BY:	DRAWN BY:	APPROVED BY:	
DATE: 9/23/75	DRAWING NO.	BK	PG
SHEET 1 OF 1	JOB NO. 57507046	REVISED:	