


**SURVEY NOTES.**

1. BLOCKS 1 AND 2 OF COLUMBIA HEIGHTS ADDITION HAVE BEEN DRAWN AND SURVEYED AS SHOWN ABOVE AS THE RESULT OF A CORRECTION AT THE ANGLE POINT AT CHERRY AVE. AND COLLEGE ST. THIS CORRECTION WAS NOTED ON A CITY OF MILTON-FREEWATER PLAT IN A PLAT BOOK BY PERSONS UNKNOWN. THE CORRECTED ANGLE USED ABOVE DOES:
  - a. AGREE WITH OLD RETAINING WALLS.
  - b. AGREE WITH CURBED STREET IMPROVEMENTS.
  - c. AGREE WITH HOUSES ERECTED ON LOTS IN BLOCKS 1 & 2.
2. DISTANCES SHOWN IN PARENTHESIS ARE EXISTING PLAT DIMENSIONS FOR LOTS 8, 9, 10, 11, 12, & 13 OF BLOCK 2.
3. ALLEY BETWEEN LOTS 6-10 AND 11-15 OF BLOCK 2 IS BEING VACATED BY THE CITY.
4. THE MEASURED DISTANCES IN BLOCK 2 WERE DIVIDED BY USING THE PERCENTAGE EACH LOT REPRESENTED IN THE ORIGINAL PLATTED DIMENSIONS AND MULTIPLYING THIS PERCENTAGE BY THE EXISTING MEASURED DISTANCES.
5. BEARINGS USED WERE TAKEN FROM A SURVEY OF A TRACT OF LAND OWNED BY REESE LAMB THAT LAYS NORTHWESTERLY OF BLOCK 1, THE TRACT WAS SURVEYED BY STANLEY WALLULIS IN JAN. 1961.

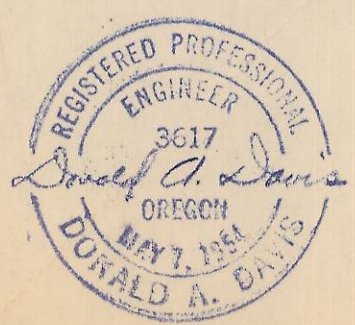

NW (12)

A PROPERTY SURVEY  
FOR  
WILLIAM C. HARSTAD  
LOTS 8-13 IN BLOCKS 2 & 3  
OF COLUMBIA HEIGHTS ADD.  
MILTON-FREEWATER, OREGON  
SCALE: 1"=40' DATE: APRIL 1961  
DRAWN BY: DONALD A. DAVIS