


**REESE LAMB DESCRIPTION:**  
 Beginning at the N.E. corner of the N.W. 1/4 of the N.W. 1/4 of the N.W. 1/4 of Section 12, Twn. 5 North, Range 35 E.W.M.; said point being a City of Milton-Freewater Monument (Stone in Valve Box); thence S 89° 33' 30" W along the northerly line of said section 12 a distance of 689.71 feet to the N.W. corner of said section 12, said point being a City of Milton-Freewater Monument (Metal Cap on Asphalt Surface); thence S 0° 00' E a distance of 1345.31 feet to an Iron Pipe (1 1/2" dia x 60") and the point of beginning for this description;  
 thence S 2° 05' 30" E a distance of 577.87 feet to an iron pin; thence N 73° 12' 15" E a distance of 228.88 feet to an iron pin; thence N 34° 24' 45" E a distance of 125.00 feet; thence S 55° 35' 15" E a distance of 25.00 feet; thence N 34° 24' 45" E a distance of 230.00 feet; thence N 50° 35' 15" W a distance of 135.00 feet; thence N 34° 24' 45" E a distance of 50.00 feet; thence S 56° 35' 15" E a distance of 43.02 feet; thence N 0° 08' 14" E a distance of 153.33 feet to an iron pin; thence S 88° 04' 10" W a distance of 414.45 feet to the point of beginning for this description.

- SURVEY NOTES:**
- 1) Dashed lines in Blocks 1 & 2 of Columbia Heights Addition above represent original block layout as indicated on original plat, and use of existing City Monuments at Maple Ave & College St., and Cherry Ave & College St.
  - 2) Solid lines in Blocks 1 & 2 of Columbia Heights Addition above are a result of a correction at the angle point at Cherry Ave & College Street. This correction was noted on a City of Milton-Freewater Plat in a Plat Book by person of persons unknown. The solid lines shown above do:
    - a) Agree with physical street improvements.
    - b) Agree with existing retaining walls defining individual properties.
  - 3) Distances shown in parenthesis are existing deed distances.
  - 4) Traverse Error Before Correction 1/1350, Angular Error 0° 01' 25"
  - 5) PURPOSE OF SURVEY: SUIT TO QUARTERS
  - 6) LINE SOUTH FROM SECTION 12 (N.W. CORNER) WAS NOT ESTABLISHED AS A SECTION LINE AND THEREFORE THIS TRACT MAY BE IN BOTH SECTIONS 11 & SECTION 12.

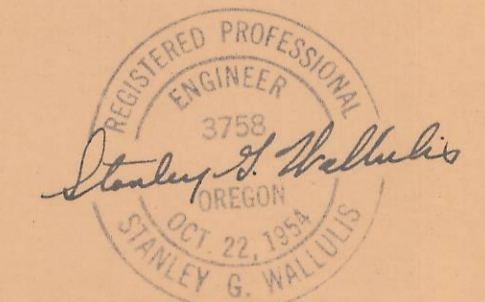

TRACT SURVEY FOR REESE LAMB  
 Located in the N.W. 1/4, Sec. 12, Twn. 5 N.,  
 R. 35 E.W.M., Umatilla County, Oregon

Scale: 1" = 50'    Dr. By: S.G.W.    Date: 1-31-61

**STANLEY G. WALLULIS**  
 Consulting Engineer  
 P.O. Box 91  
 Pendleton, Oregon

C-966-C

BC