


MONUMENT AND CAP DESCRIPTION:

Monument Type: Size:

Cap Type: Brass Disk Size: 0.070 M Diameter.
bridge.

Monument is flush with concrete in

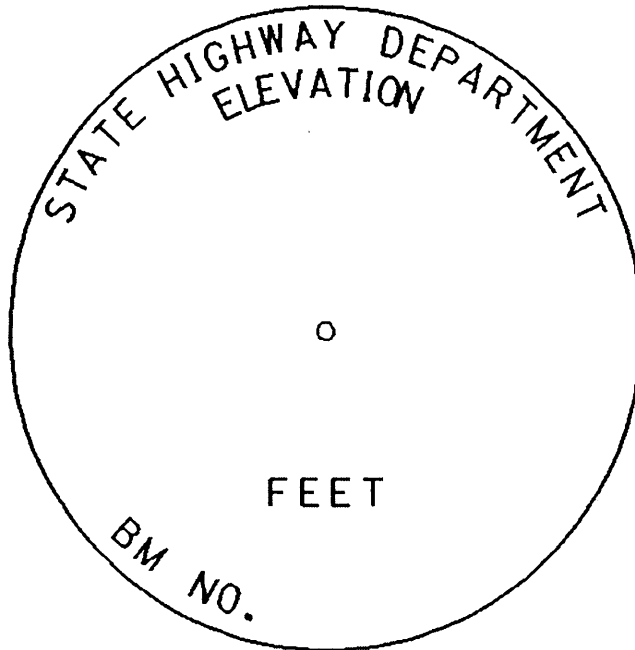

RECEIVED BY

Umatilla County Surveyor

Date: 4-98

Rec'd By: KK

No. 98-56-6